

8

7

6


5

4

3

1

|           |                  |                     |     |          |          |
|-----------|------------------|---------------------|-----|----------|----------|
| DATE CODE | REV NO           | NO                  | REV | 1        |          |
| 25390     | 165CB-001-801-04 | 1                   | -   |          |          |
| REVISIONS |                  |                     |     |          |          |
| ZONE      | REV              | DESCRIPTION         |     | DATE     | APPROVED |
| ALL       | -                | ISSUED FOR APPROVAL |     | 20-03-02 | S.D.     |

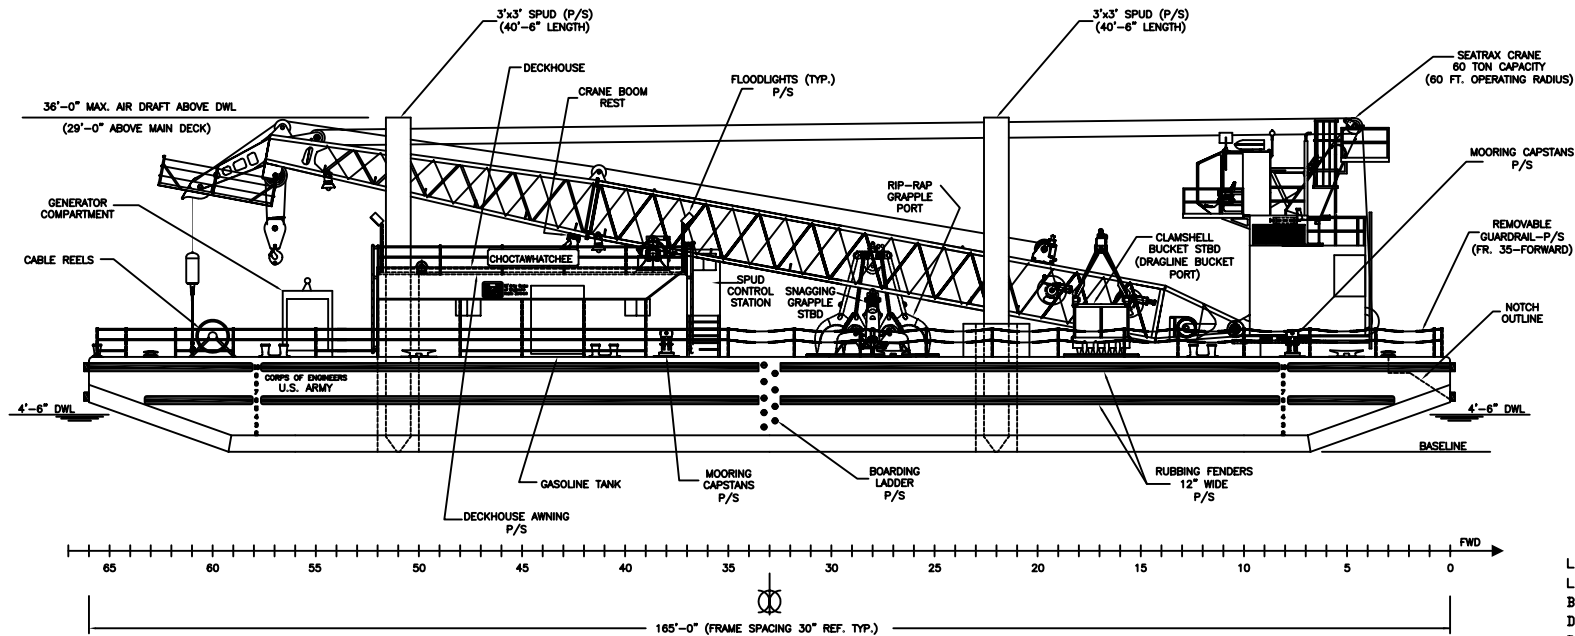

OUTBOARD PROFILE VIEW


## PRINCIPAL CHARACTERISTICS

LENGTH OVER ALL ..... 165'-0"  
LENGTH BETWEEN PERPENDICULARS .. 165'-0"  
BEAM ..... 50'-0"  
DEPTH (NO CAMBER) ..... 11'-6"  
DESIGN DRAFT ..... 4'-6"

|                                                                                                                   |                  |                                                              |
|-------------------------------------------------------------------------------------------------------------------|------------------|--------------------------------------------------------------|
| 5                                                                                                                 | 165CB-001-100-01 | WELDING SCHEDULE                                             |
| 4                                                                                                                 | 165CB-001-130-01 | HULL SCANTLING PLAN / MAIN DECK & BTM SHELL                  |
| 3                                                                                                                 | 165CB-001-117-03 | HULL SCANTLING PLAN / AFT END                                |
| 2                                                                                                                 | 165CB-001-117-02 | MIDSHIP                                                      |
| 1                                                                                                                 | 165CB-001-117-01 | HULL SCANTLING PLAN / FORWARD END                            |
| NO.                                                                                                               | DRAWING NO.      | TITLE                                                        |
| REFERENCES                                                                                                        |                  |                                                              |
| APPROVALS                                                                                                         |                  |                                                              |
| ABS                                                                                                               | ABS_APPROVAL     |                                                              |
| USCG                                                                                                              | USCG_APPROVAL    |                                                              |
| OWNER                                                                                                             | OWN_APPROVAL     |                                                              |
| <div>BENDER</div> <div>Bender Shipbuilding &amp; Repair Co., Inc.<br/>165 FT CRANE BARGE - 165CB-001-100-01</div> |                  | <div>165FT-CRANE-BARGE</div> <div>OUTBOARD<br/>PROFILE</div> |
| DATE/ISSUED                                                                                                       | 7291             | FC                                                           |
| APPROVED/SIGNED                                                                                                   | B.R.             | S.D.                                                         |
| S.DANIELS                                                                                                         |                  |                                                              |
| FILE NAME                                                                                                         |                  |                                                              |

|               |                  |         |      |
|---------------|------------------|---------|------|
| DATE          | CHKD             | APP'D   | REV  |
| D 25390       | 165CB-001-801-04 |         | -    |
| SCALE 1/8"=1' | 583-C205-01      | SHEET 1 | OF 1 |

THIS DOCUMENT IS THE EXCLUSIVE PROPERTY OF THE BENDER SHIPBUILDING & REPAIR CO., INC. AND IS FURNISHED ON A CONFIDENTIAL BASIS. NO PORTION OF THIS DOCUMENT MAY BE COPIED, TRACED, PHOTOGRAPHED, OR IN ANY OTHER WAY REPRODUCED NOR MAY ANY ITEM HEREON DEPICTED BE MANUFACTURED AS SHOWN WITHOUT THE WRITTEN CONSENT OF BENDER SHIPBUILDING & REPAIR CO., INC. THE RECIPIENT OF THE INFORMATION HEREON MAY NOT DISCLOSE OR MAKE AVAILABLE THE SAME TO ANY OTHER PERSON OR BUSINESS FIRM NOR MAY INFORMATION BE USED EXCEPT FOR THE SPECIFIC PURPOSE INTENDED.

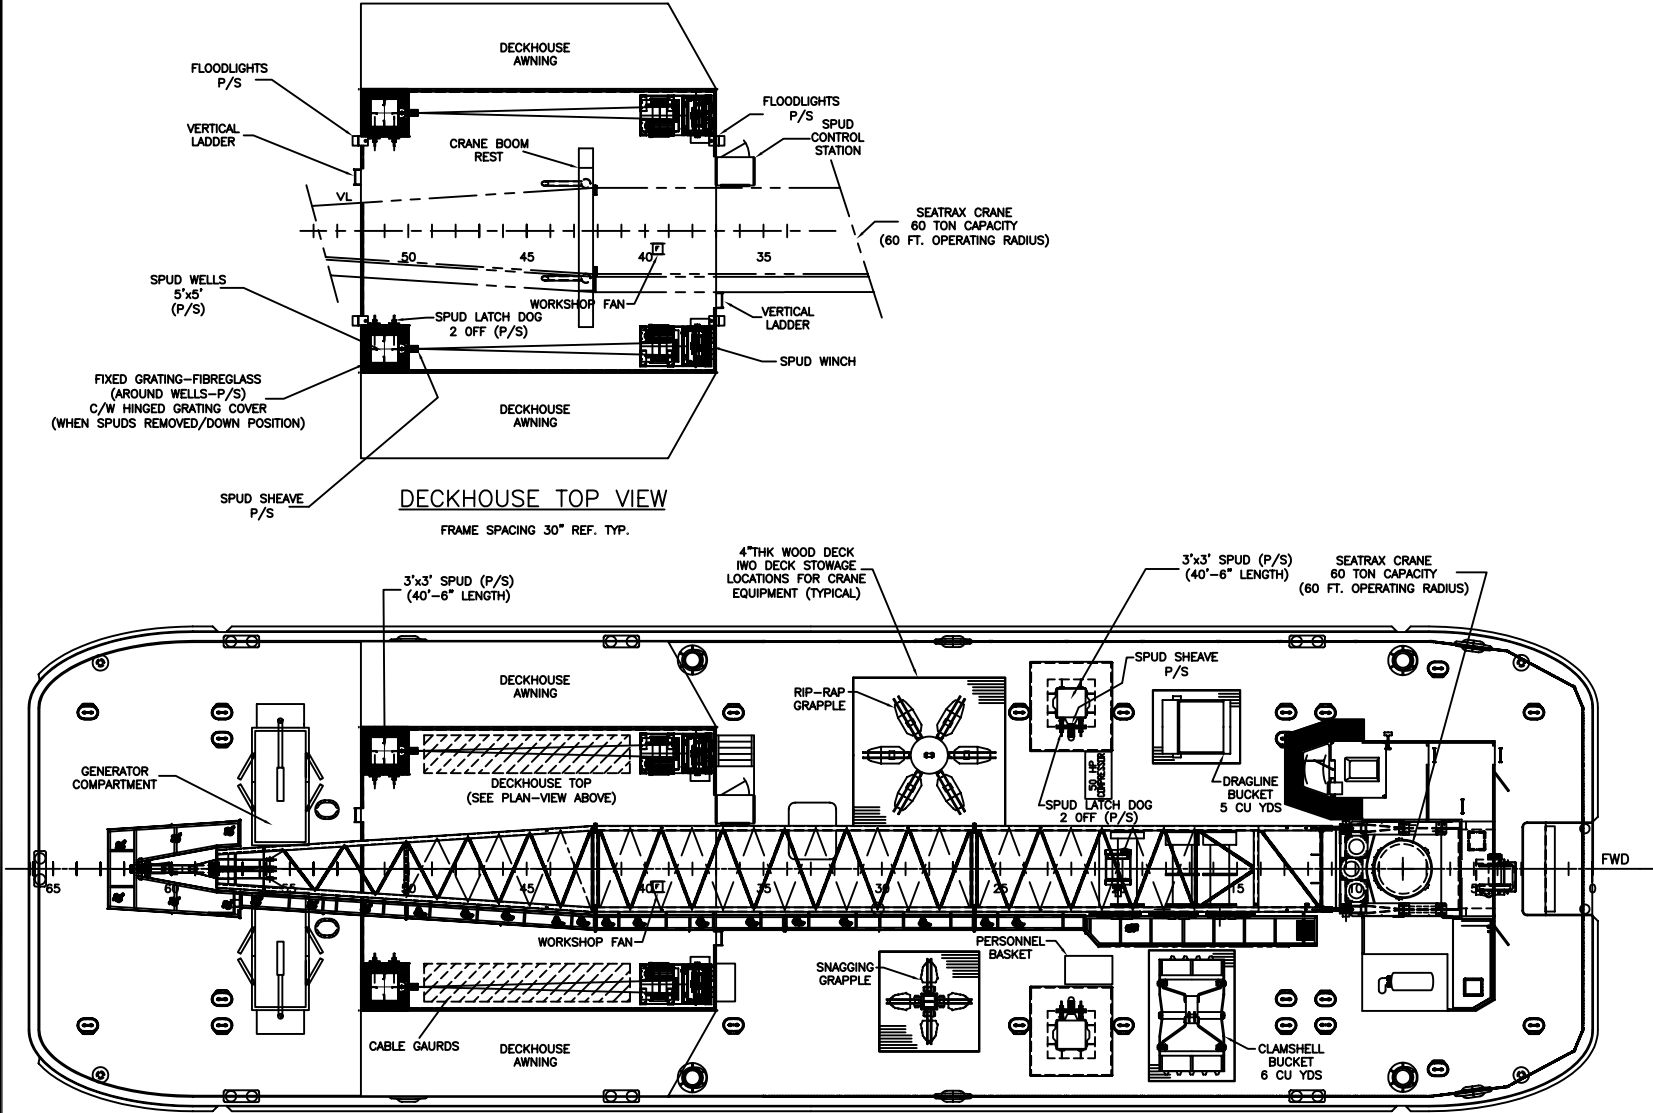

PLAN VIEW @ CRANE BOOM LEVEL

|            |                  |                 |                                                        |
|------------|------------------|-----------------|--------------------------------------------------------|
| 7          | 165CB-AB1-582-02 | 618-D554-01     | SPUD HANDLING SYSTEM                                   |
| 6          | 165CB-AB1-123-01 | 618-D552-01     | SPUDWELLS                                              |
| 5          | 165CB-AB1-100-01 | 618-D305-06     | WELDING SCHEDULE                                       |
| 4          | 165CB-AB1-130-01 | 618-D305-05     | HULL SCANTLING PLAN / MAIN DECK & BTM SHELL            |
| 3          | 165CB-AB1-117-04 | 618-D305-04     | HULL SCANTLING PLAN / CL BHD, OUTBD BHD AND SIDE SHELL |
| 2          | 165CB-AB1-117-02 | 618-D305-02     | HULL SCANTLING PLAN / MIDSHIP SECTIONS                 |
| 1          | 165CB-AB1-117-01 | 618-D305-01     | HULL SCANTLING PLAN / FORWARD END                      |
| NO.        | DRAWING NO.      | MDC DRAWING NO. | TITLE                                                  |
| REFERENCES |                  |                 |                                                        |

PRINCIPAL CHARACTERISTICS

LENGTH OVER ALL \_\_\_\_\_ 165'-0"  
LENGTH BETWEEN PERPENDICULARS \_\_\_\_ 165'-0"  
BEAM \_\_\_\_\_ 50'-0"  
DEPTH (NO CAMBER) \_\_\_\_\_ 11'-6"  
DESIGN DRAFT \_\_\_\_\_ 4'-6"

**BENDER**  
SHIPBUILDING & REPAIR CO., INC.

BENDER JOB NO  
7291

LOC  
FC0901

DRAWN BY:  
B.R.


CHECKED BY:  
S.D

APPROVED BY:  
KT

FILE NAME  
V:\7291\ADMIN\DESIGN\AS-BUILT\AB1-801-01-


**165FT-CRANE-BARGE**  
**GENERAL**  
**ARRANGEMENT**

|                |                   |                             |          |
|----------------|-------------------|-----------------------------|----------|
| SIZE<br>B      | FSCM NO.<br>25390 | DWG NO.<br>165CB-AB1-801-01 | REV<br>- |
| SCALE 1/16"=1' | 618-D215-01       | SHEET 1 OF 3                |          |

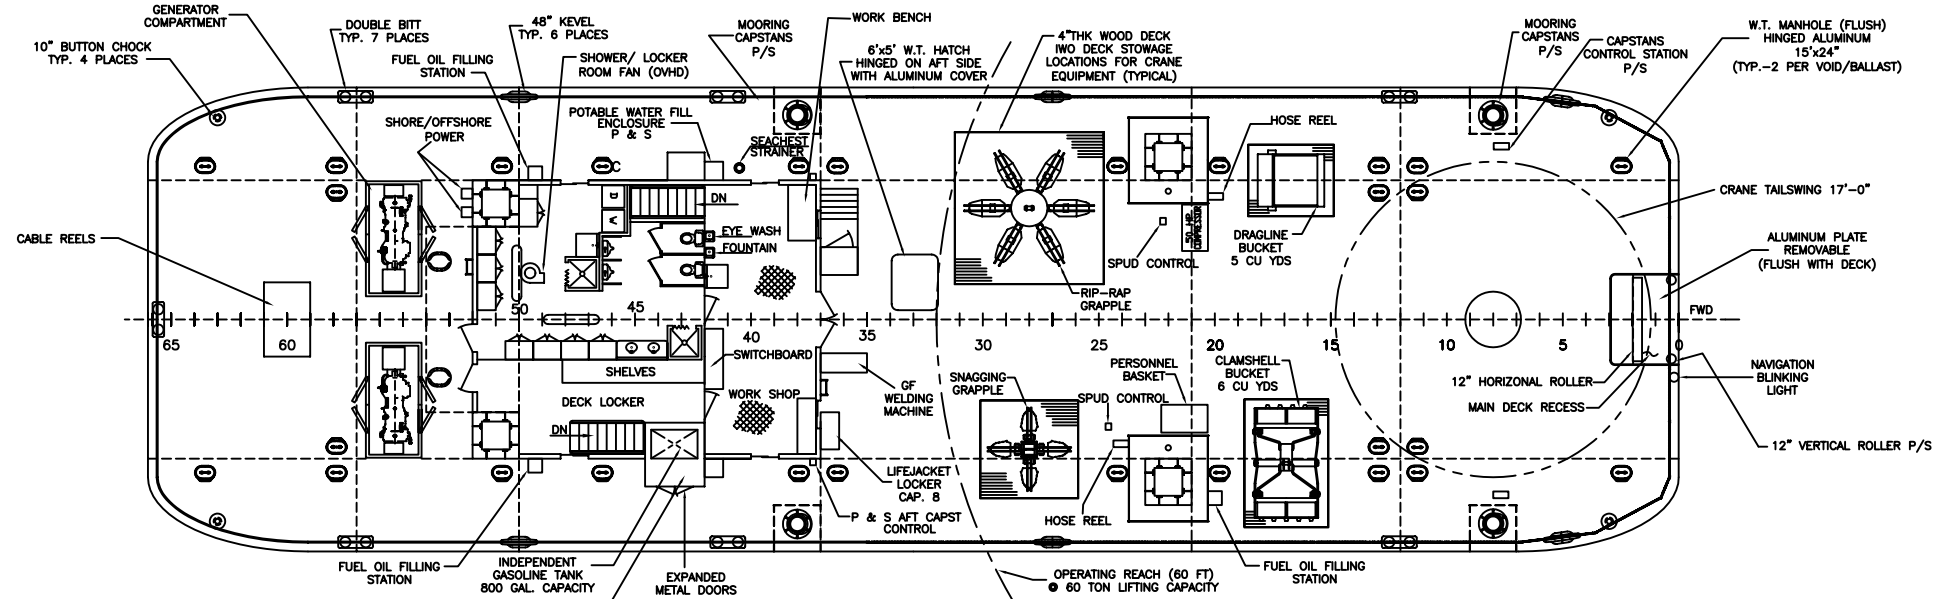

MAIN DECK PLAN VIEW

FRAME SPACING 30" REF. TYP.

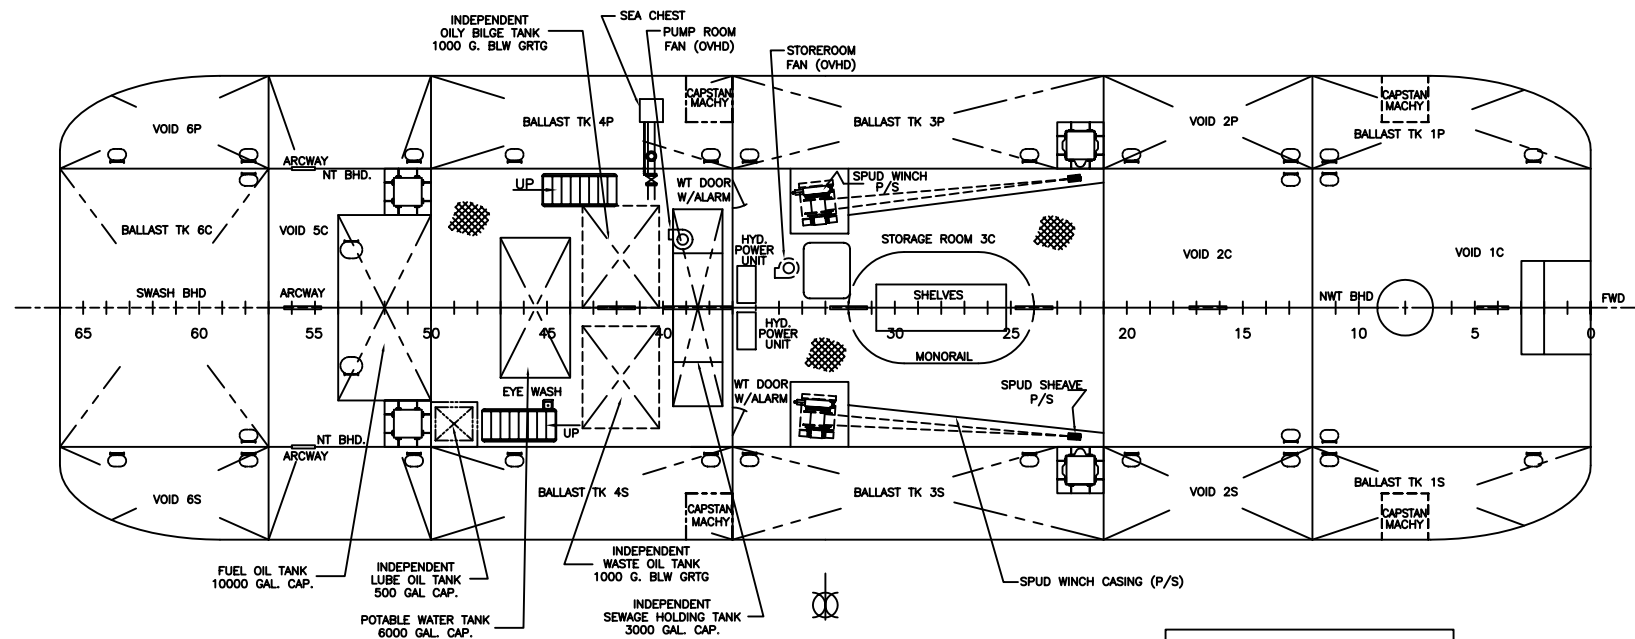

HOLD-PLAN VIEW

FRAME SPACING 30" REF. TYP.

# BENDER

SHIPBUILDING &amp; REPAIR CO., INC.

DRAWN BY: B.L.R.

FILE:

|  |      |
|--|------|
|  | SIZE |
|--|------|

|          |    |
|----------|----|
| FSCM NO. | 05 |
|----------|----|

|        |     |
|--------|-----|
| DWG NO | 105 |
|--------|-----|


|        |                  |
|--------|------------------|
| DWG NO | 165CB-AB1-801-01 |
|--------|------------------|

|     |  |
|-----|--|
| REV |  |
|-----|--|

SCALE 1/16"X1'

618-D215-01

SHEET 2 OF 3

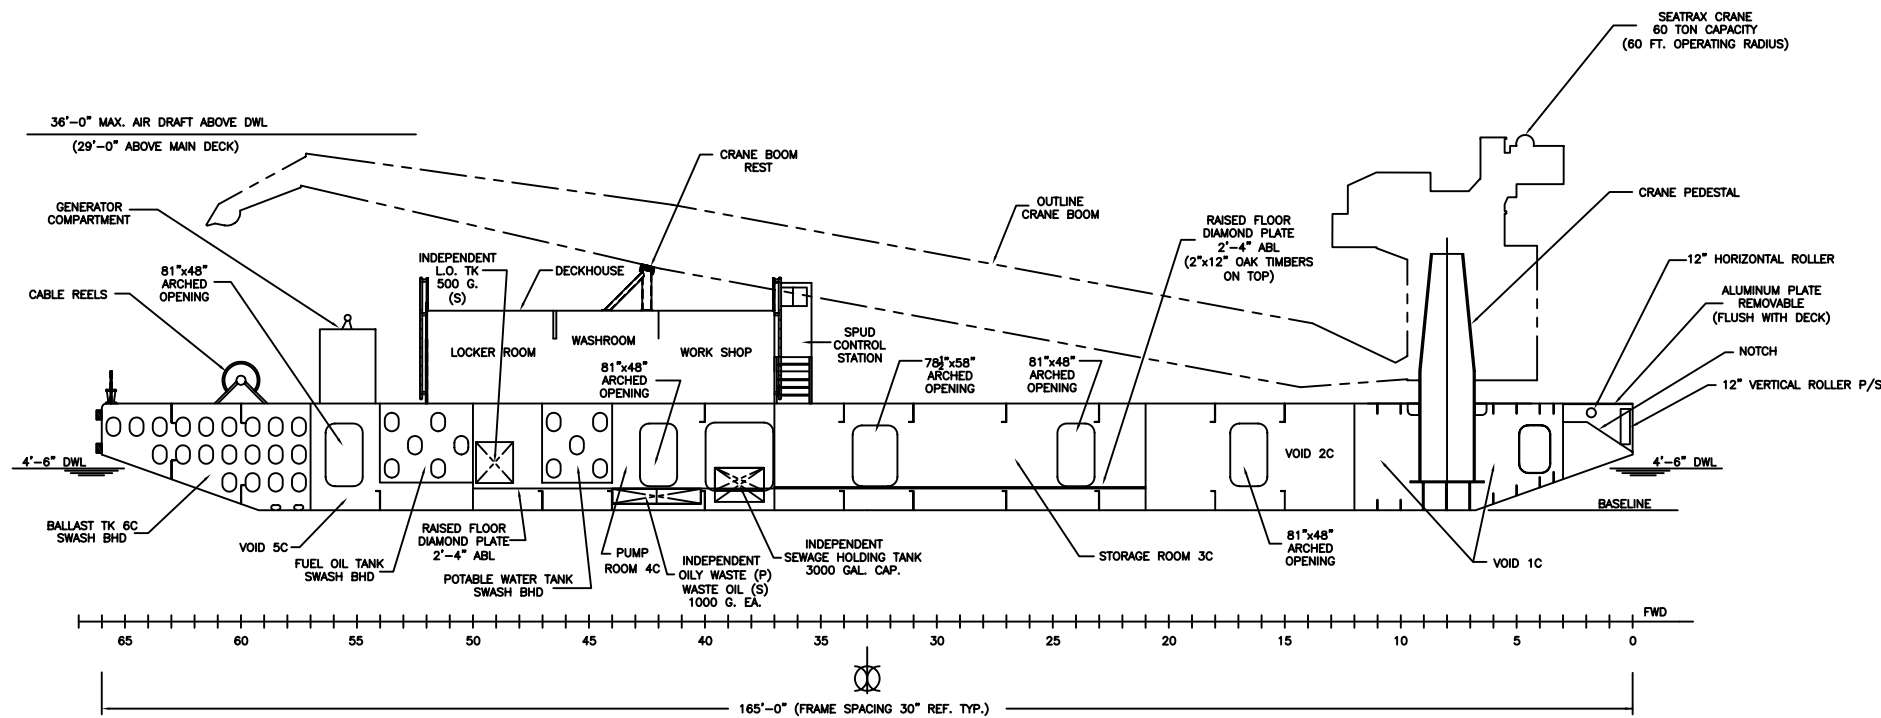

INBOARD C.L. PROFILE

**BENDER**

SHIPBUILDING & REPAIR CO., INC.

DRAWN BY: B.L.R.

FILE:

|                  |                   |                             |              |
|------------------|-------------------|-----------------------------|--------------|
| SIZE<br><b>B</b> | FSCM NO.<br>25390 | DWG NO.<br>165CB-AB1-801-01 | REV<br>-     |
| SCALE 1/16"X1'   |                   | 618-D215-01                 | SHEET 3 OF 3 |