


REVISIONS			
LTR	DESCRIPTION	DATE	APPROVED
-	AS-BUILT	9/8/09	

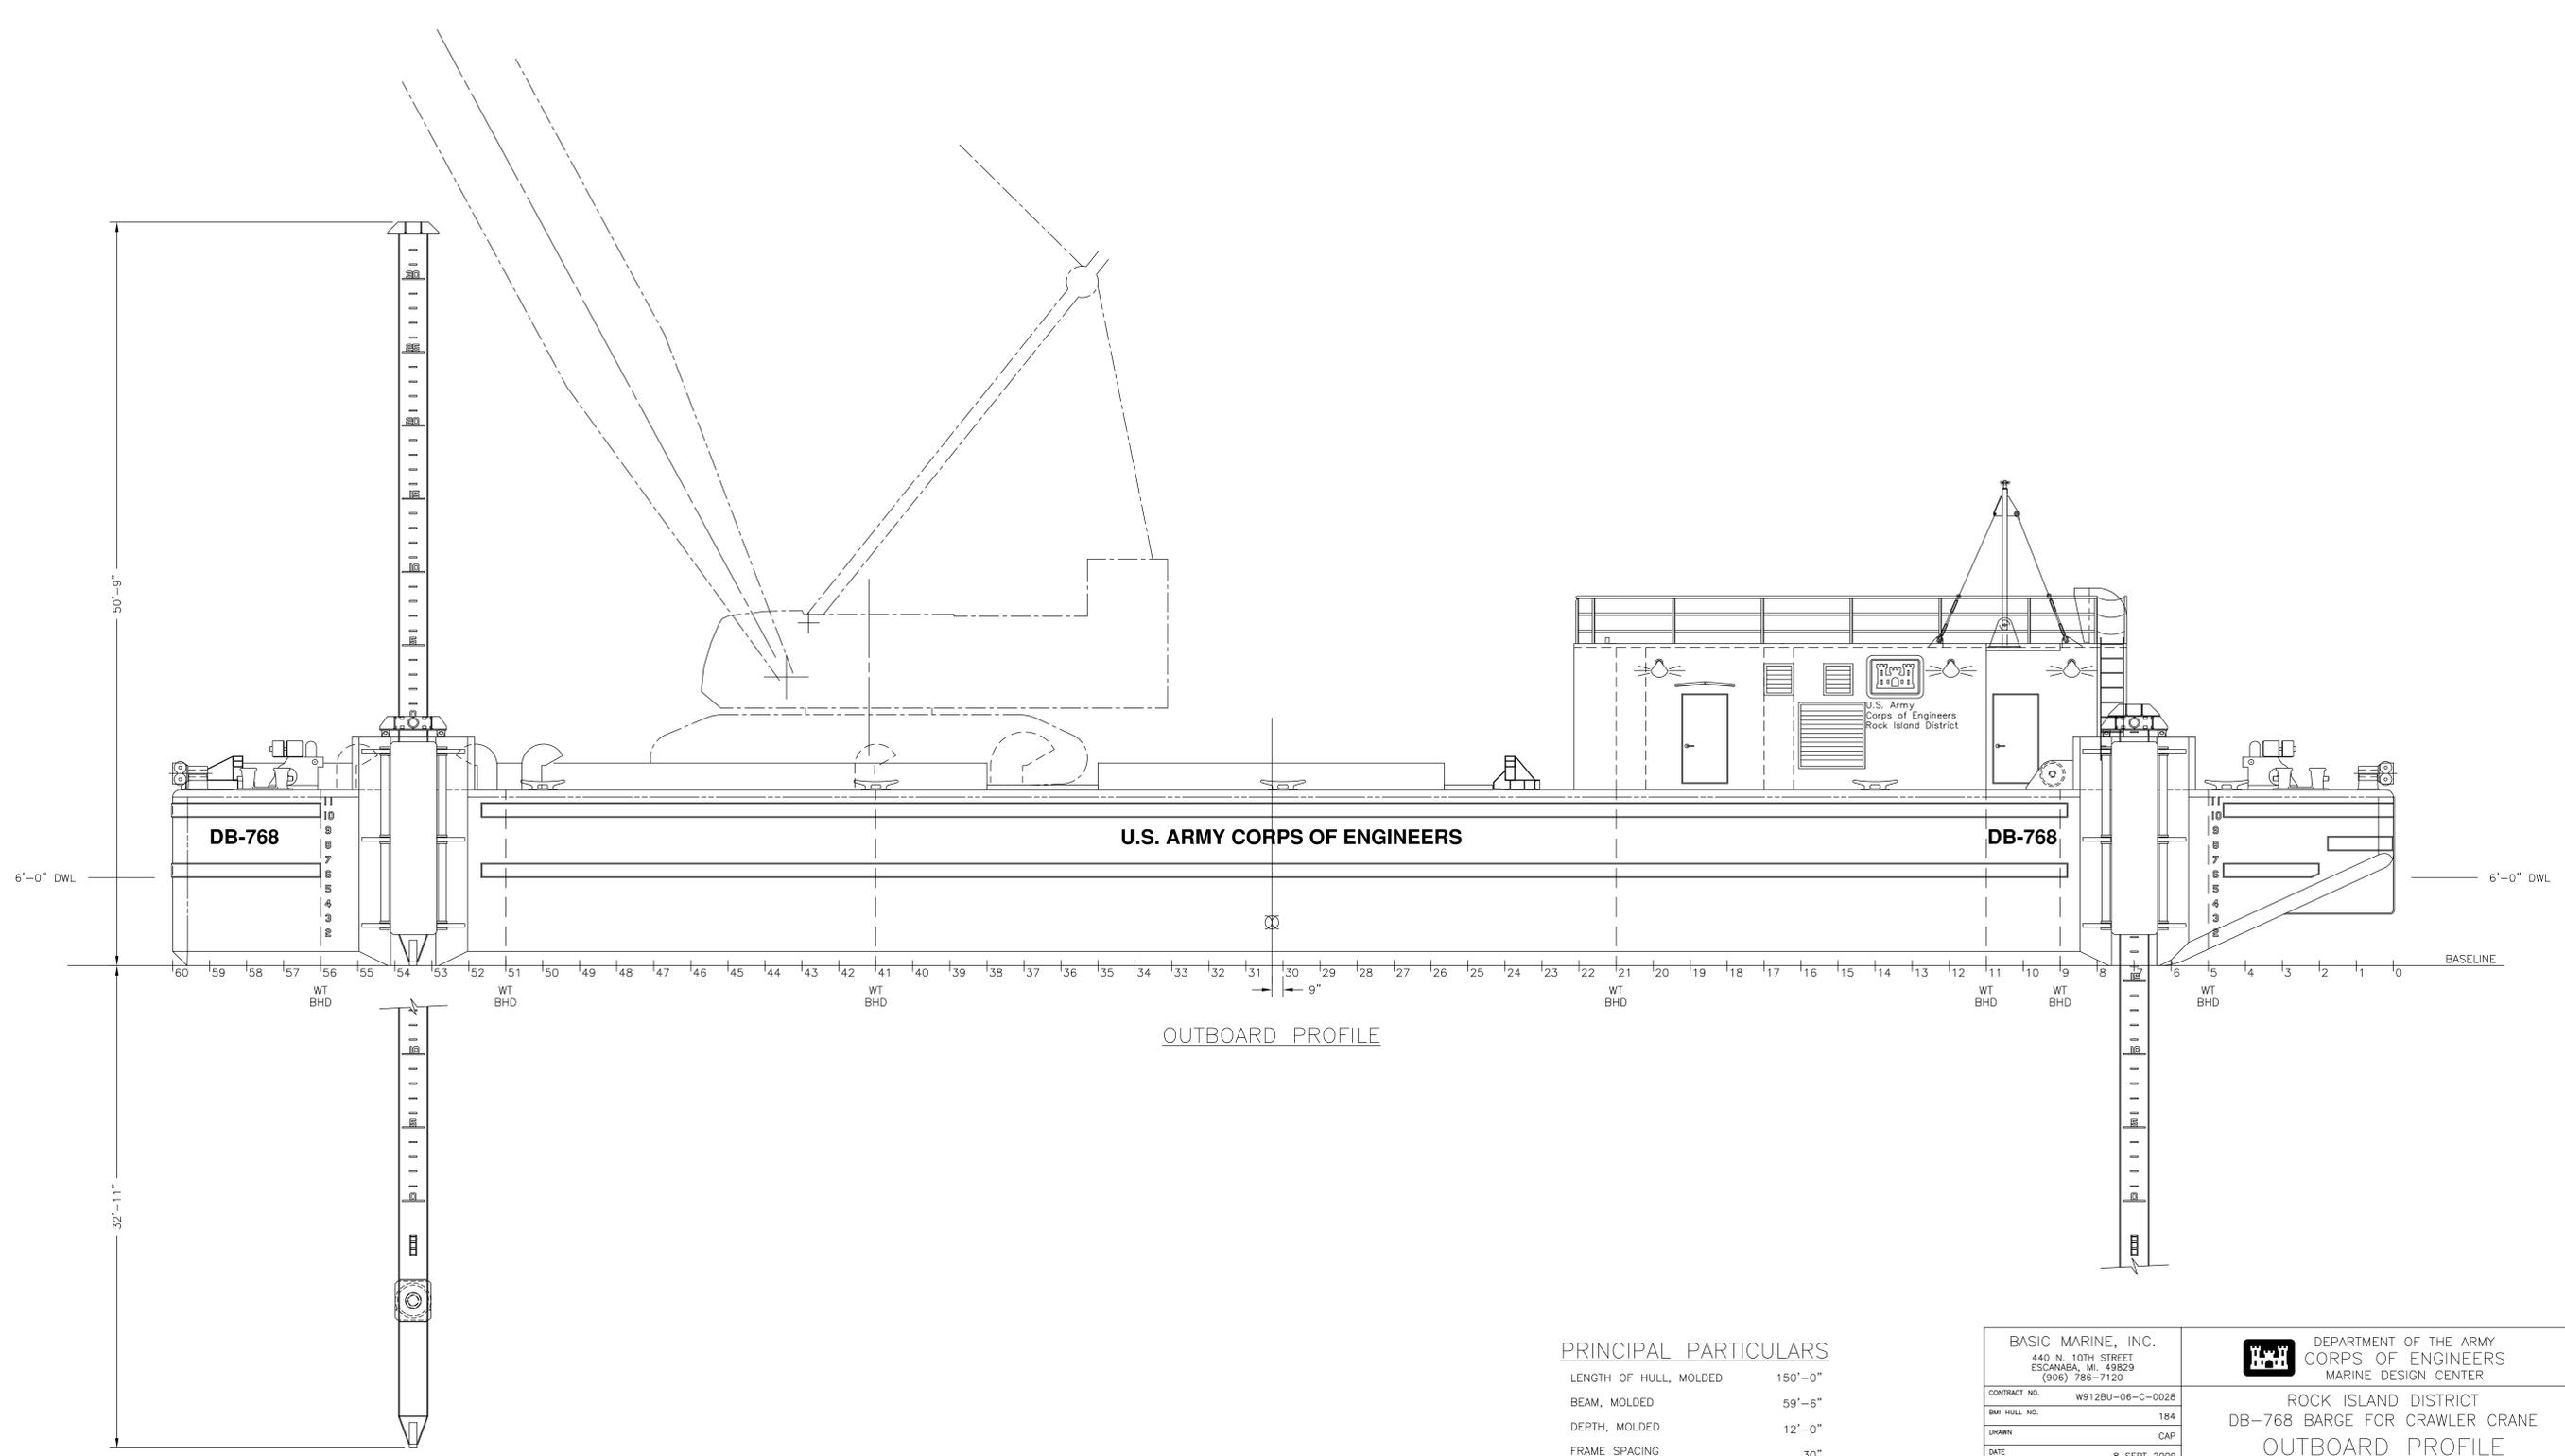


OUTBOARD PROFILE

PRINCIPAL PARTICULARS

LENGTH OF HULL, MOLDED	150'-0"
BEAM, MOLDED	59'-6"
DEPTH, MOLDED	12'-0"
FRAME SPACING	30"

BASIC MARINE, INC. 440 N. 10TH STREET ESCANABA, MI. 49829 (906) 786-7120		 DEPARTMENT OF THE ARMY CORPS OF ENGINEERS MARINE DESIGN CENTER	
CONTRACT NO. W912BU-06-C-0028 BMI HULL NO. 184 DRAWN CAP DATE 8 SEPT 2009		ROCK ISLAND DISTRICT DB-768 BARGE FOR CRAWLER CRANE OUTBOARD PROFILE	
APPROVED BY	DESIGN BY SEACRAFT DESIGN, LLC PO BOX 234, STURGEON BAY, WI 54235 FILE 07002	SIZE D PROJECT NO. 2481 SCALE 3/16" = 1'-0"	DWG. NO. 664-D205-01 SHEET 1 OF 1

REVISIONS			
LTR	DESCRIPTION	DATE	APPROVED
-	AS-BUILT	9/8/09	

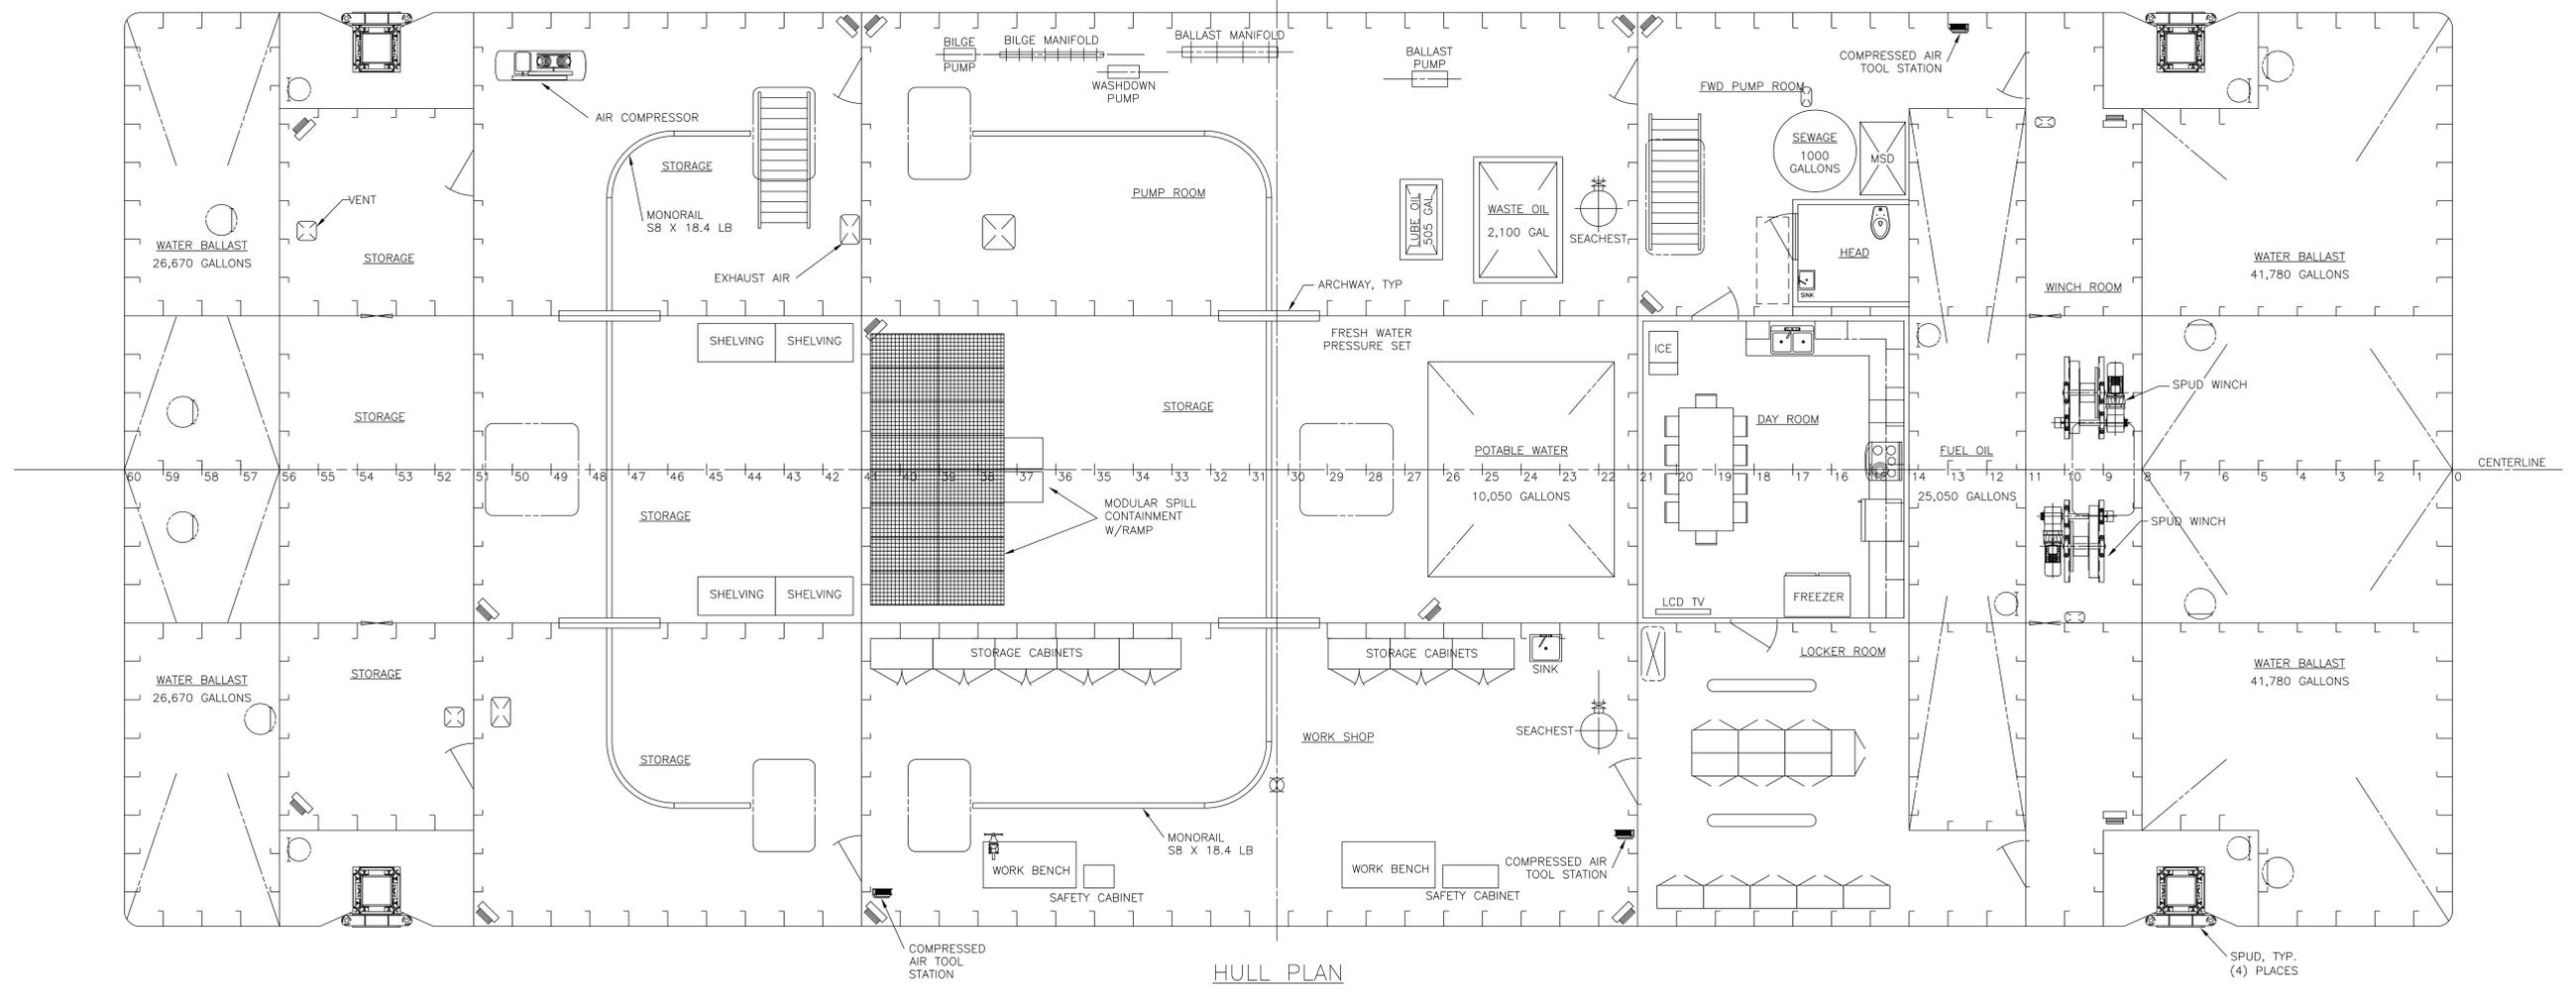


HULL PLAN

PRINCIPAL PARTICULARS


LENGTH OF HULL, MOLDED	150'-0"
BEAM, MOLDED	59'-6"
DEPTH, MOLDED	12'-0"
FRAME SPACING	30"

BASIC MARINE, INC. 440 N. 10TH STREET ESCANABA, MI. 49829 (906) 786-7120		DEPARTMENT OF THE ARMY CORPS OF ENGINEERS MARINE DESIGN CENTER	
CONTRACT NO. W912BU-06-C-0028 BMI HULL NO. 184 DRAWN CAP DATE 8 SEPT 2009		ROCK ISLAND DISTRICT DB-768 BARGE FOR CRAWLER CRANE GENERAL ARRANGEMENT	
APPROVED BY DESIGN BY SEACRAFT DESIGN, LLC PO BOX 234, STURGEON BAY, WI 54235 FILE 07002	SIZE D PROJECT NO. 2481 SCALE 3/16" = 1'-0"	DWG. NO. 664-D215-01	REV - SHEET 1 OF 2


16 15 14 13 12 11 10 9

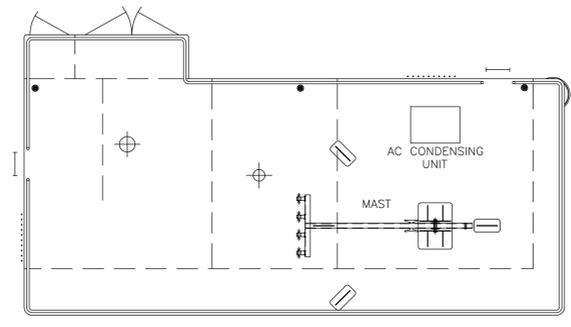

PORT HOUSE TOP

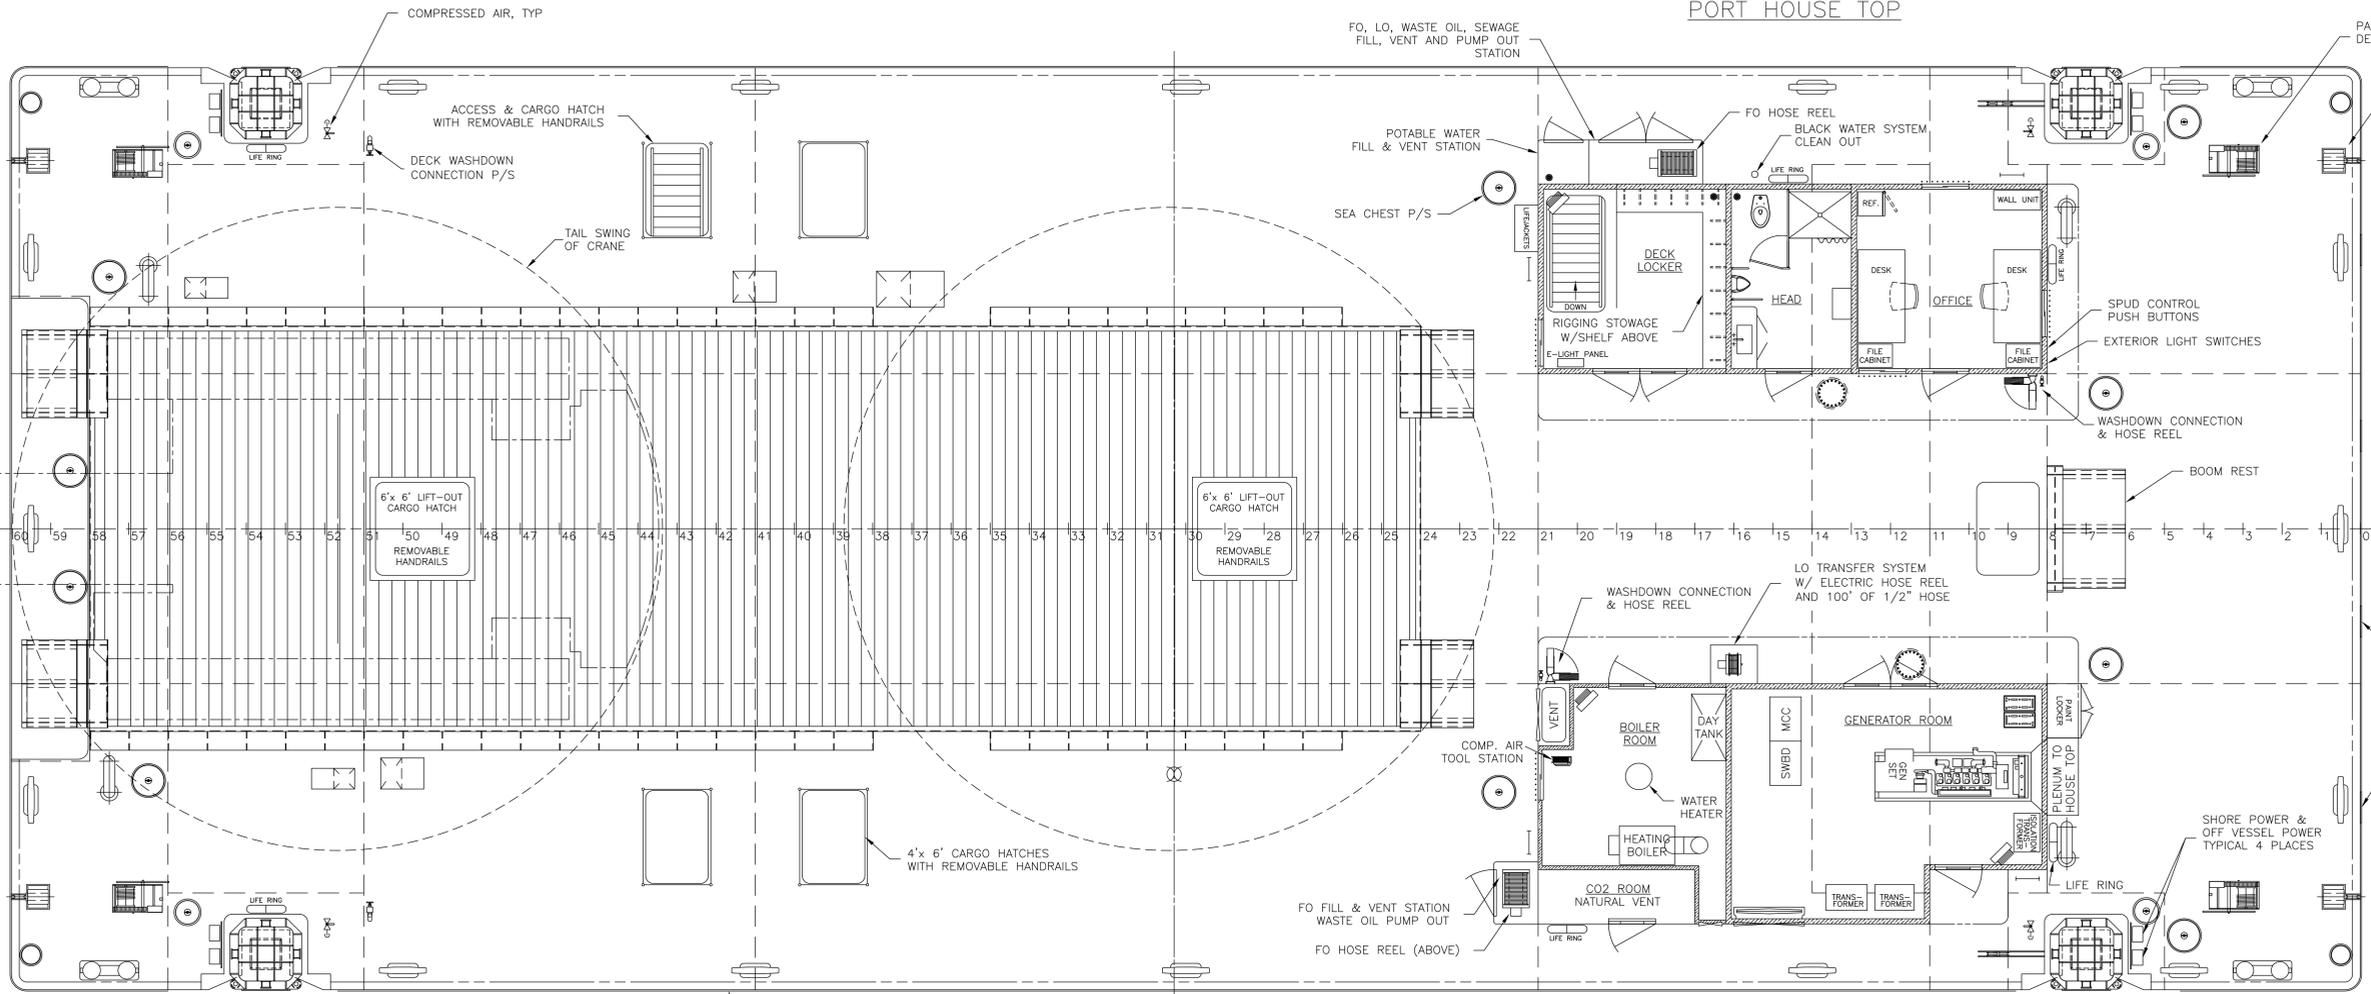

DECK PLAN

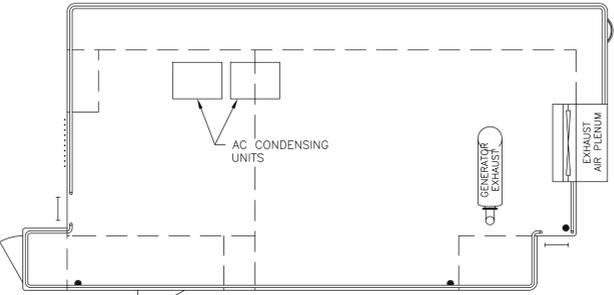

STBD HOUSE TOP

SIZE	PROJECT NO.	DWG. NO.	REV
D	2481	664-D215-01	-
SCALE 3/16" = 1'-0"			SHEET 2 OF 2

16 15 14 13 12 11 10 9