




PORT SIDE LOOKING INBOARD

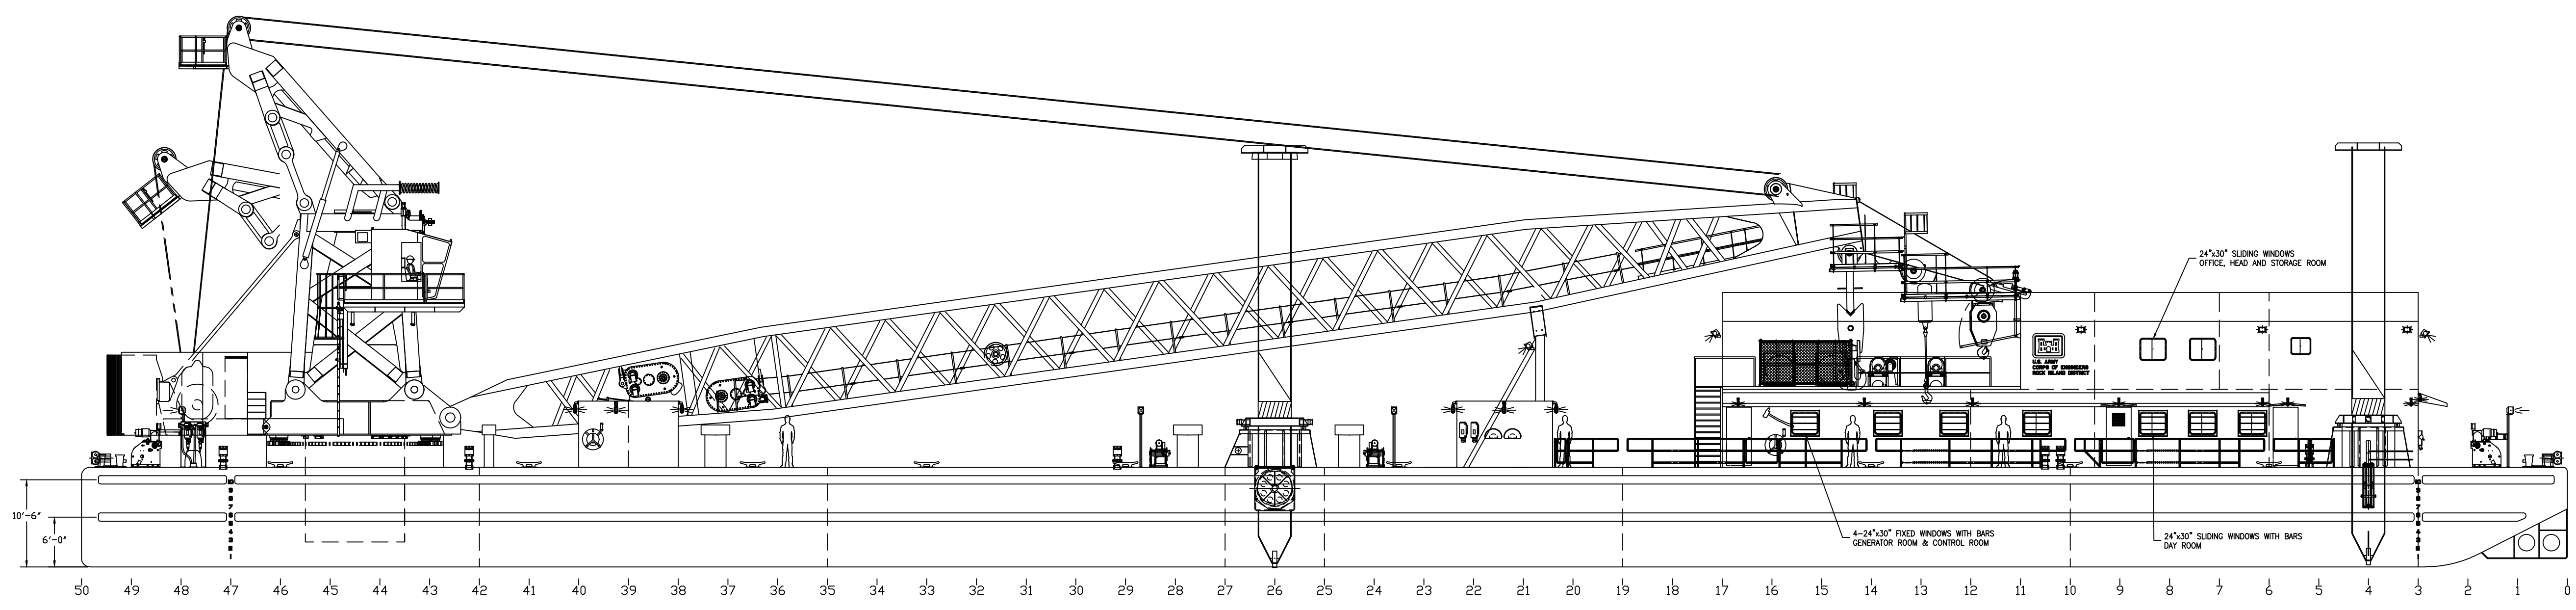

STARBOARD SIDE LOOKING INBOARD

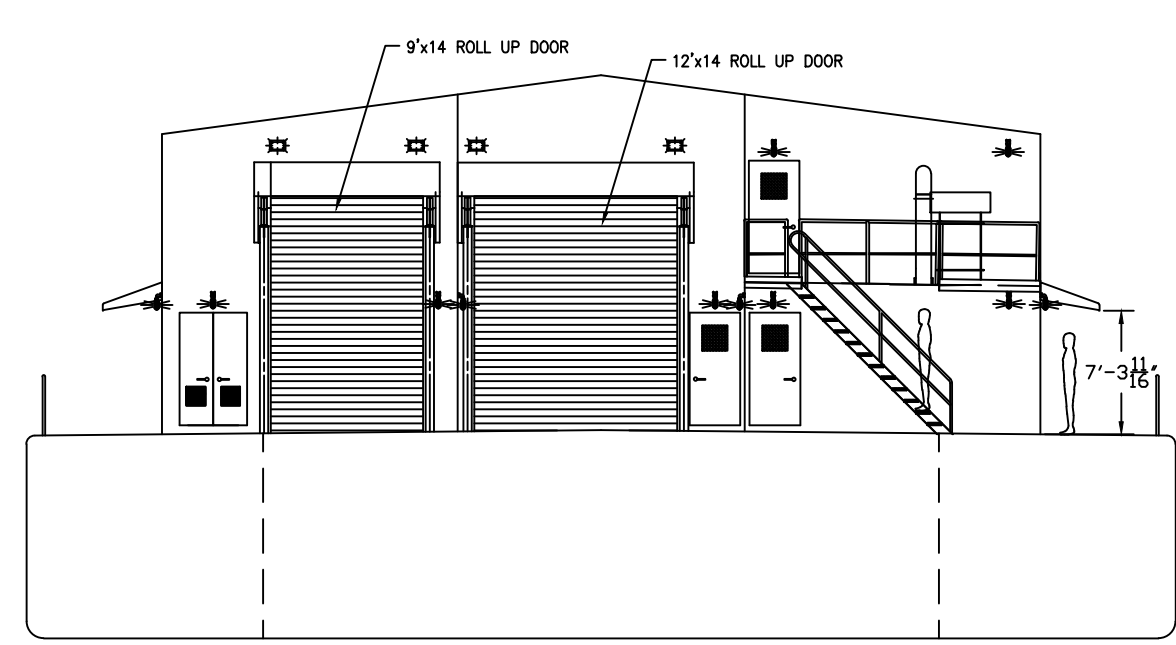

STERN END LOOKING FWD
CRANE NOT SHOWN FOR CLARITY

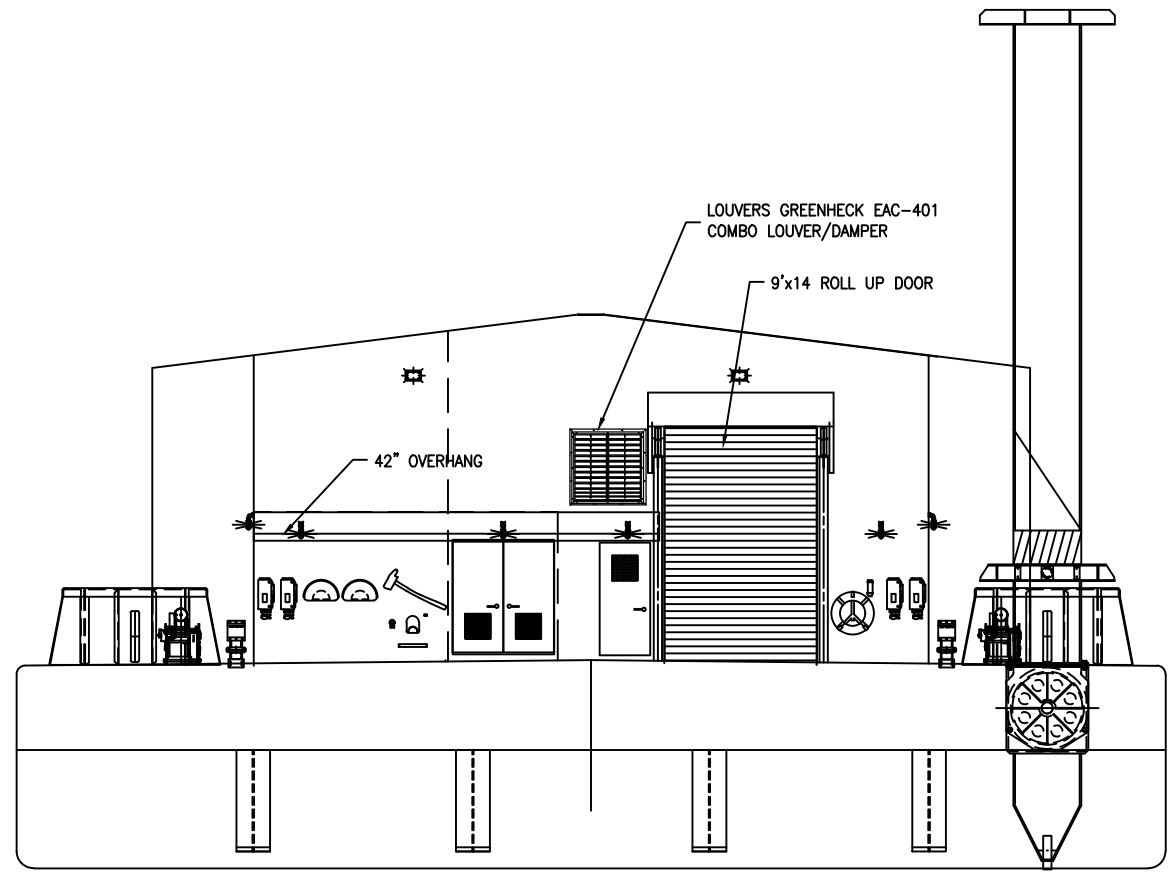

BOW END LOOKING AFT

CONRAD AS-BUILT
7/23/2019

CONRAD Shipyard, L.L.C.

DRAWN BY: BSR CHECKED BY: BSR
 DATE: 07/31/2017 CONRAD HALL # 1167
 CONRAD DWG #: C1167-801-F2
 MARINE DESIGN CENTER

DEPARTMENT OF THE ARMY
 MARINE DESIGN CENTER
 CORPS OF ENGINEERS
 215 656-6850

CEMVR, FLOATING CRANE
 300'x 68'x 12'

US Army Corps of Engineers

OUTBOARD PROFILE

PROJECT NO: 703-D205-01
 SHEET 1 OF 1

REV.	ZONE	DESCRIPTION	DATE	DRAWN	CHECKED
REVISION HISTORY					