


REVISIONS			
SYM.	DESCRIPTION	DATE	APPROVED
-	AS-BUILT	8/27/15	SM

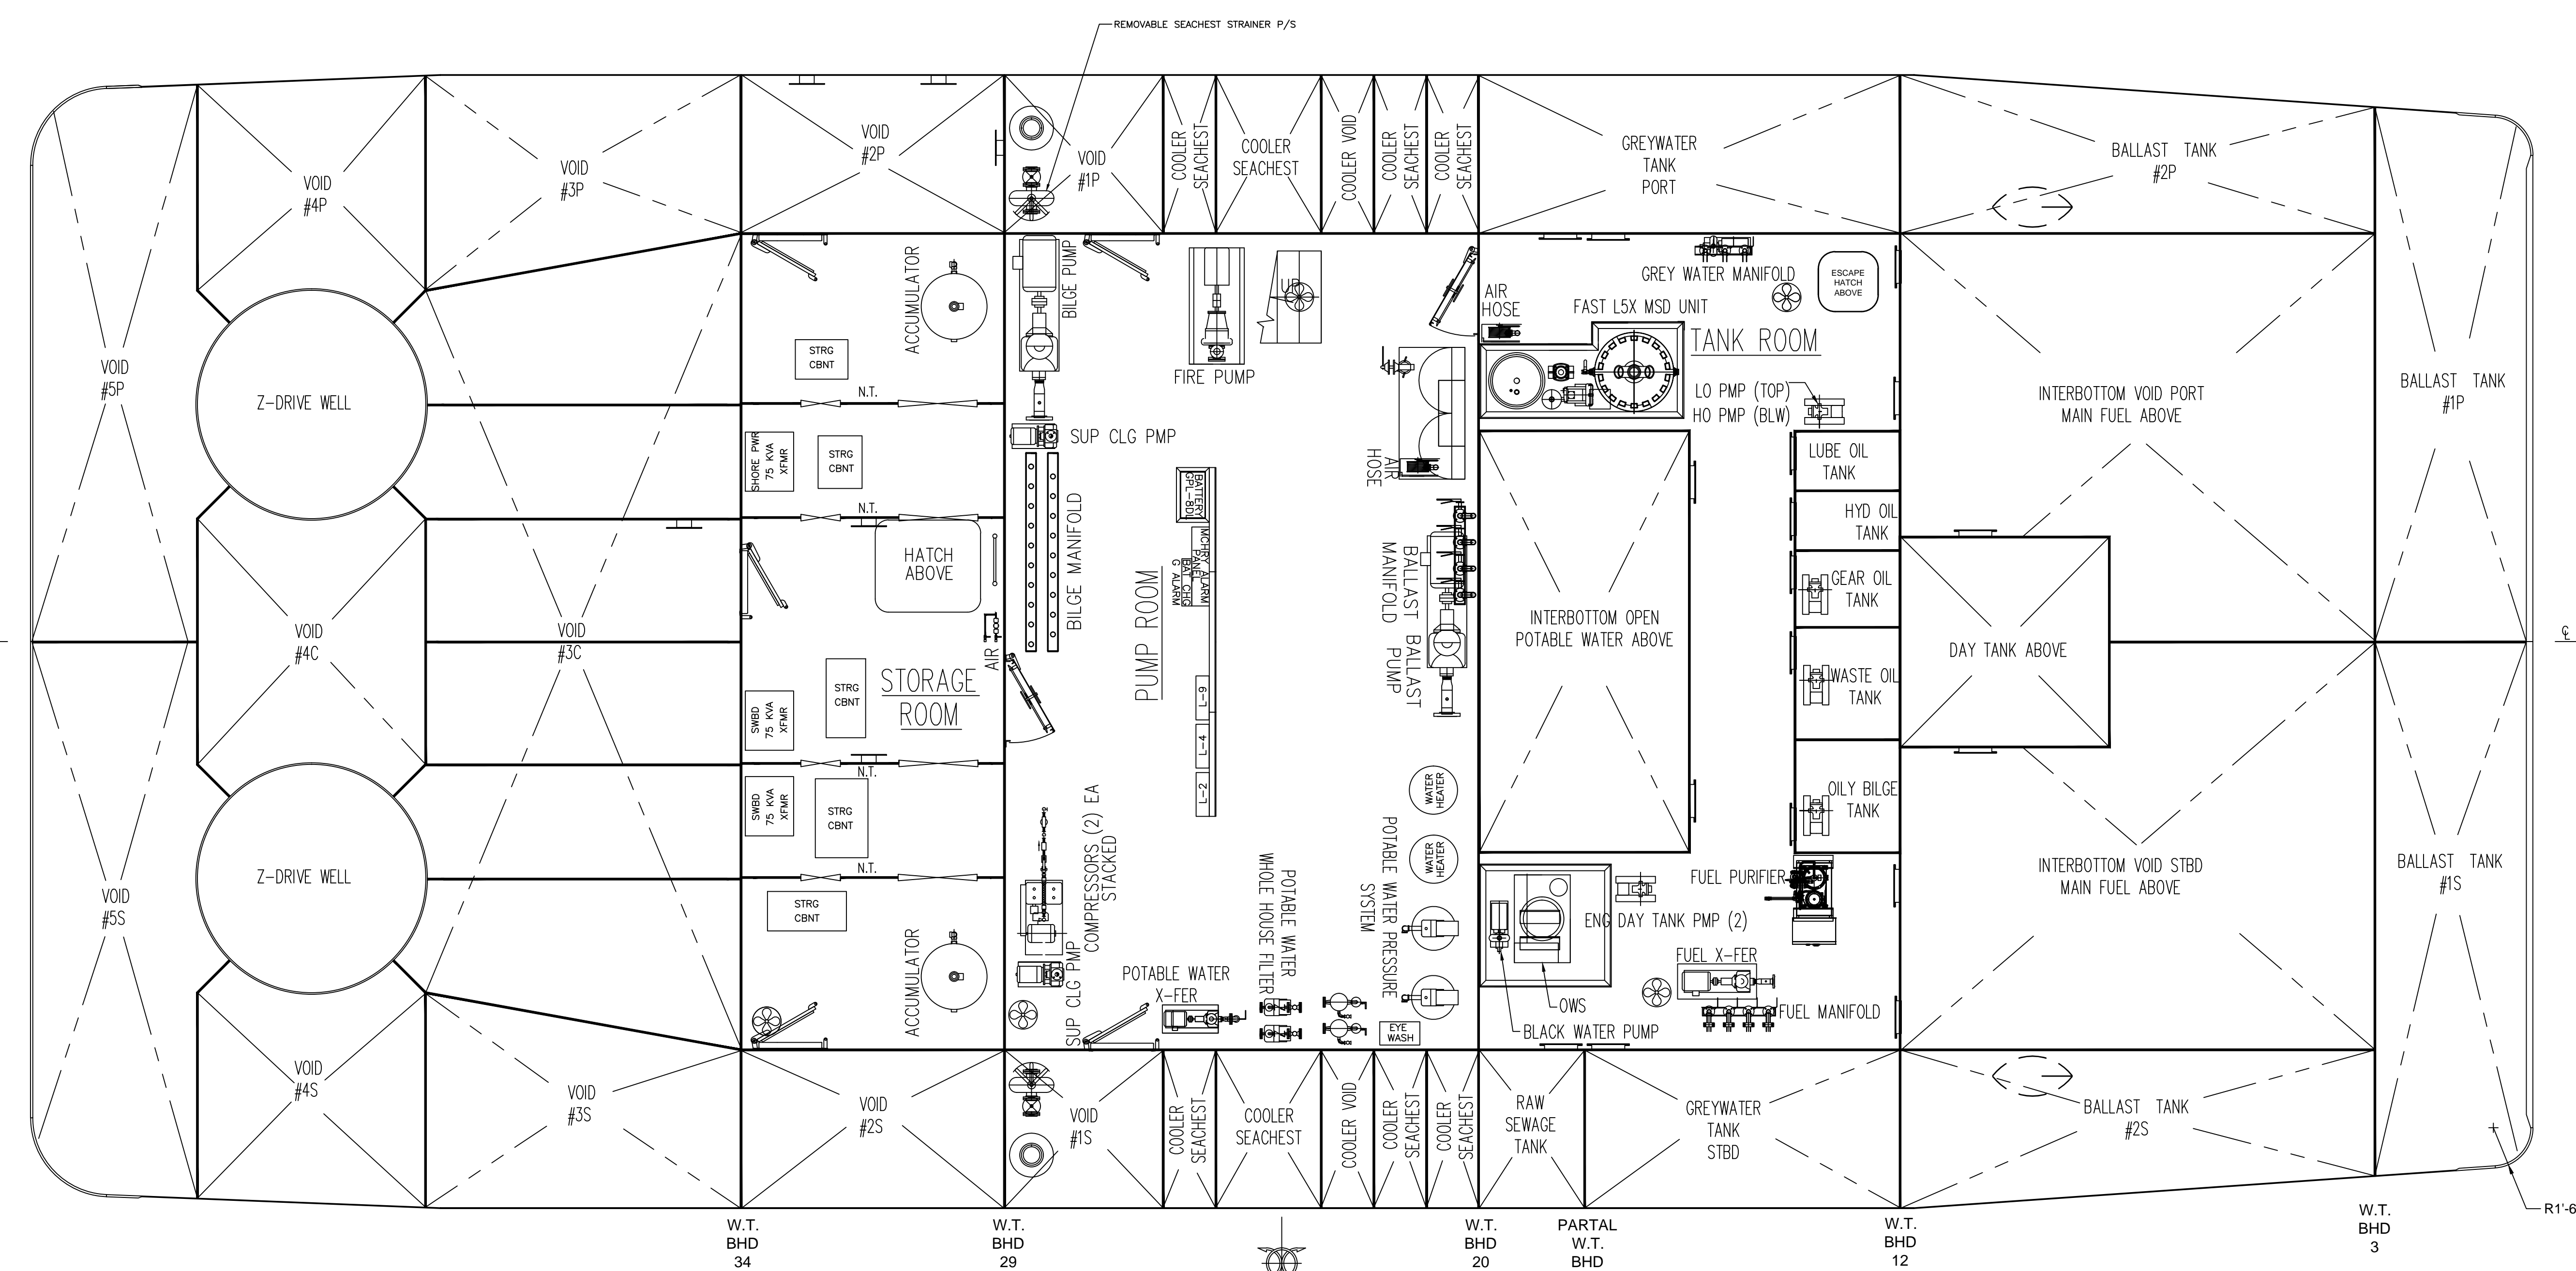

HOLD ARRANGEMENT

NO.	TITLE	DWG. NO.
REFERENCES		

HORIZON SHIPBUILDING Inc. 13980 SHELL BELT RD BAYOU LA BATRE, AL.		DEPARTMENT OF THE ARMY MARINE DESIGN CENTER CORPS OF ENGINEERS LITTLE ROCK DISTRICT - TOWBOAT DAN REEVES - 95'x43'x10'	
DRAWN BY: BO/JSJ	CHECKED BY: JRC	US Army Corps of Engineers	
DATE: 11/27/13	CONTRACT NO. W912BU-13-C-0062		
MARINE DESIGN CENTER		APPROVED: D	PROJECT NO. 2885
		DWG. NO. 793-D215-01	REV. -
		SCALE: 1/4" = 1'-0"	
		SHEET 1 OF 4	