


REVISIONS			
SYM.	DESCRIPTION	DATE	APPROVED
-	AS-BUILT	8/27/15	SM

PRINCIPAL CHARACTERISTICS

LENGTH OVERALL	95'-0"
BEAM MOLDED	43'-0"
DEPTH @ MIDSHIP SIDE	10'-0"
DESIGN DRAFT	8'-6"

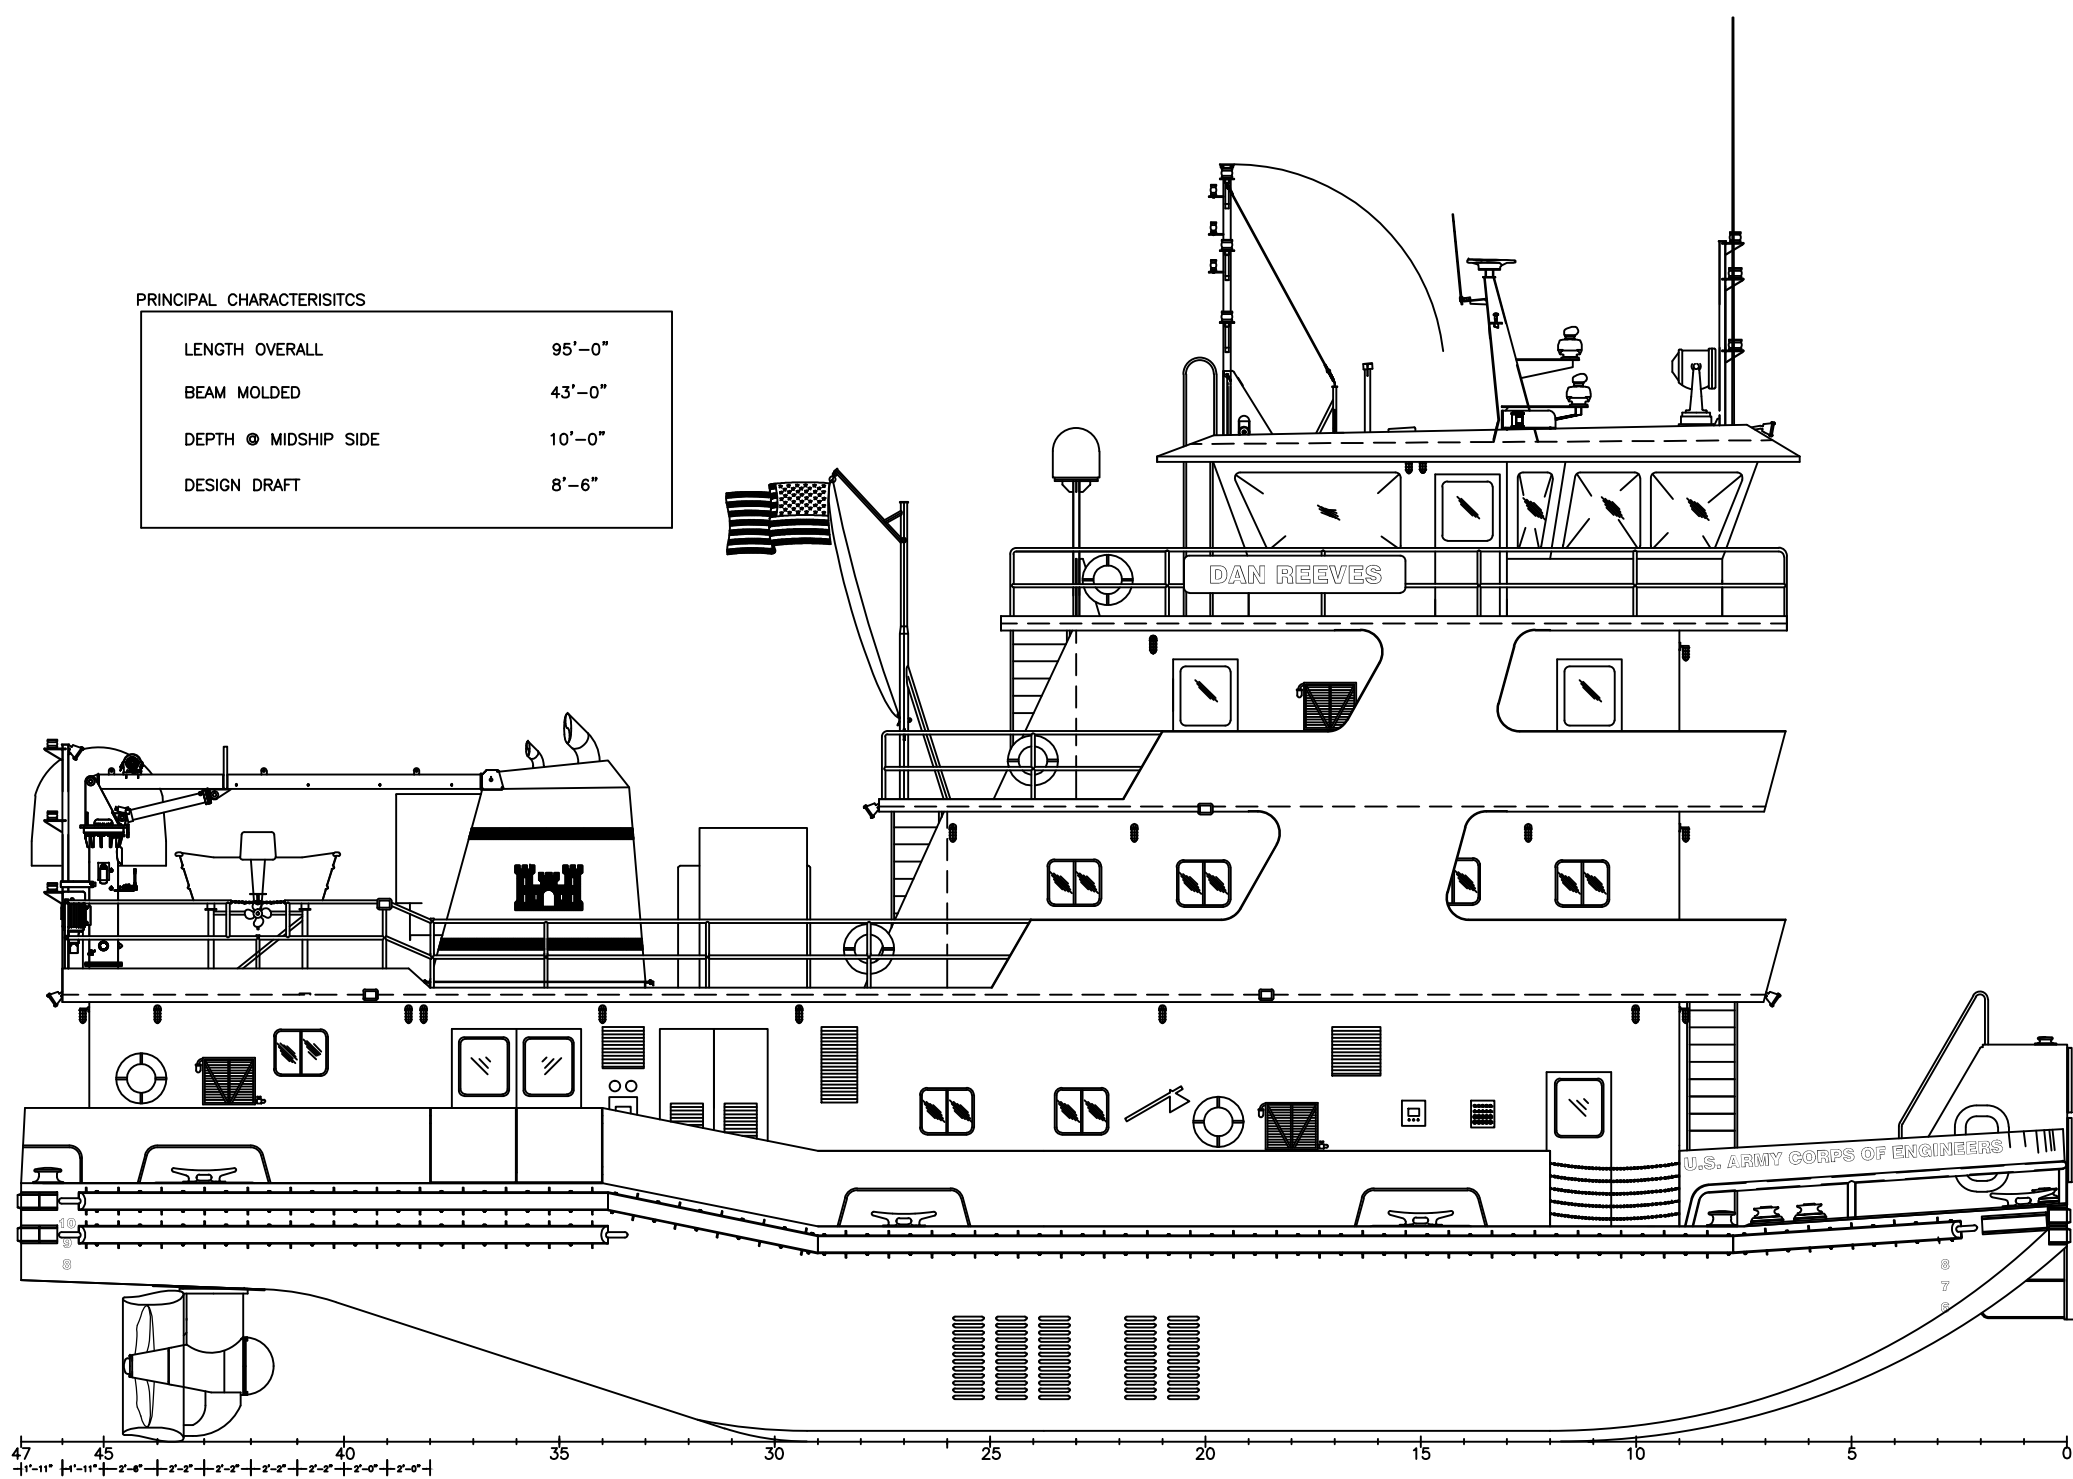

FIXED BRIDGE HEIGHT 47'-9 5/8" @ 8'-6" DRAFT

PILOT HOUSE TOP 46'-6" ABL

36'-0" EYE HEIGHT @ 8'-0" DRAFT

PILOT HOUSE DECK 38'-0" ABL

TEXAS DECK 29'-6" ABL

UPPER DECK 21'-0" ABL

MAIN DECK 10'-0" ABL

DWL

HULL PROFILE

NO.	TITLE	DWG. NO.
REFERENCES		

HORIZON SHIPBUILDING Inc. 13980 SHELL BELT RD BAYOU LA BATRE, AL.		DEPARTMENT OF THE ARMY MARINE DESIGN CENTER CORPS OF ENGINEERS	
DRAWN BY: JOW	CHECKED BY: SM	US Army Corps of Engineers	
DATE: 8/27/15	CONTRACT NO. W912BU-13-C-0062		
MARINE DESIGN CENTER		LITTLE ROCK DISTRICT - TOWBOAT DAN REEVES - 95x43x10' <b>OUTBOARD PROFILE</b>	
APPROVED:	DATE:	SIZE PROJECT NO. D 2885	DWG. NO. 793-D205-01
SCALE: 1/4" = 1'-0"		SHEET 1 OF 1	