


REVISIONS		
SYM	DESCRIPTION	DATE APPROVED
0	AS BUILT; ISSUED AS 'REV. 0'	9-21-99

**PARTICULARS**

LENGTH \_\_\_\_\_ 106' - 10"  
 BEAM \_\_\_\_\_ 27' - 0"  
 DRAFT \_\_\_\_\_ 8' - 0"  
 DEPTH \_\_\_\_\_ 21' - 3"  
 HORSE POWER \_\_\_\_\_ 1280 HP

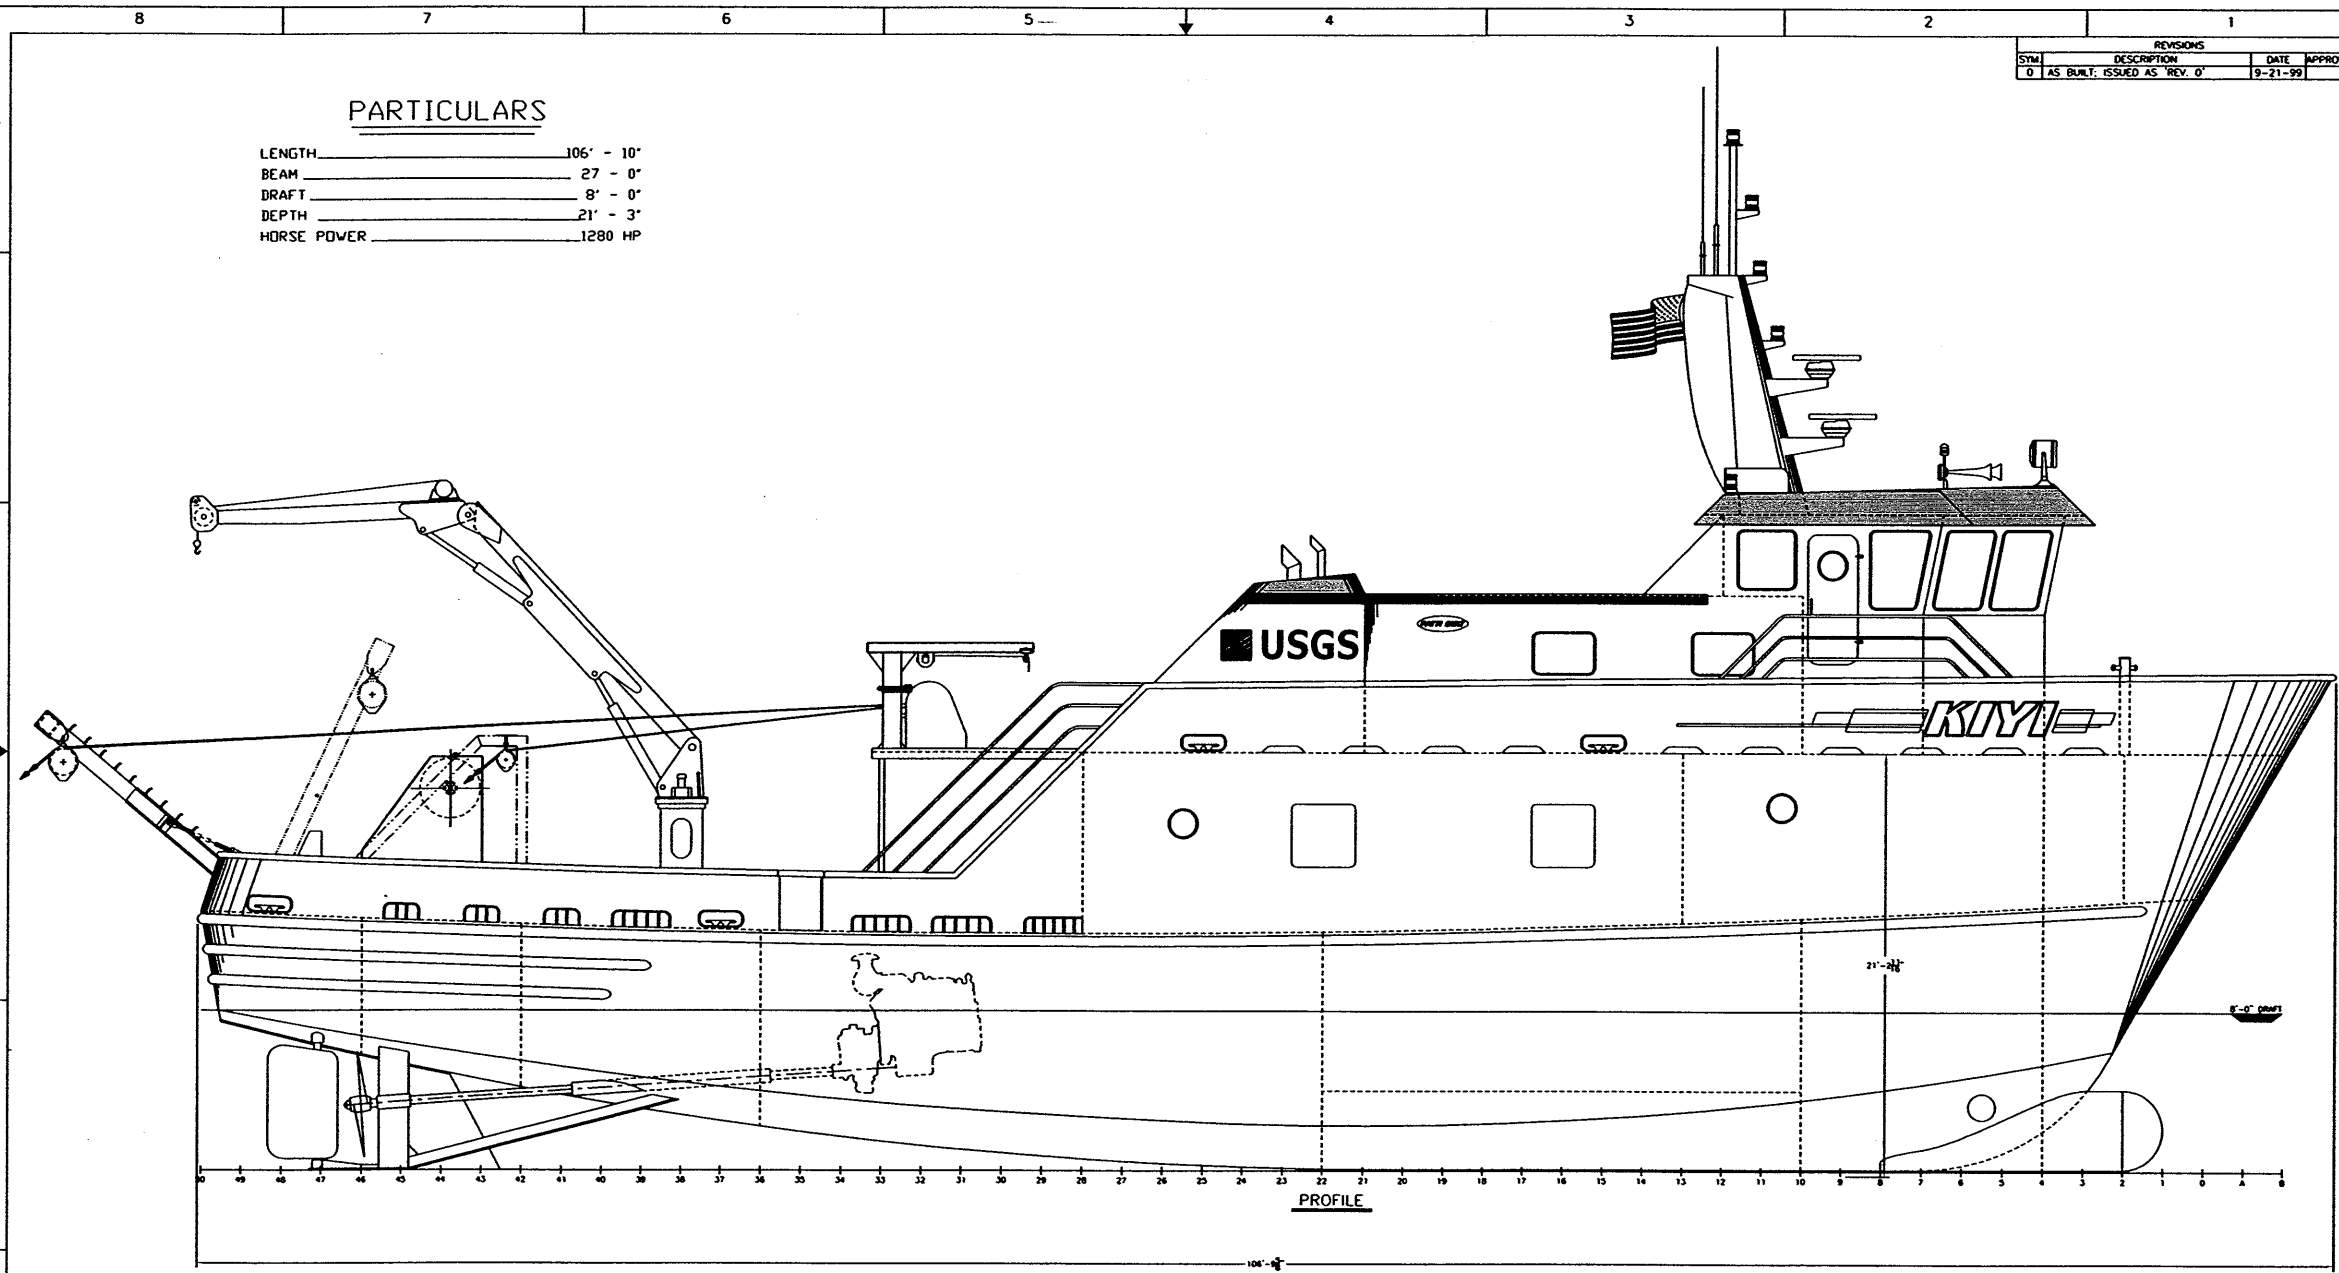

**PROFILE**

NO.	TITLE	DWG. NO.

**REFERENCES**

PATRI SHIPPING INC. T. CHRYER F. PATRI 3-2-98 MARINE DESIGN CENTER		DEPARTMENT OF THE ARMY MARINE DESIGN CENTER CORPS OF ENGINEERS GREAT LAKES RESEARCH VESSEL (DWC HULL 589) OUTBOARD PROFILE DWG. NO. 589-D205-01 SHEET 1 OF 1	
--	--	---	--