


REVISIONS			
REV.	DESCRIPTION	DATE	APPROVED
-	AS-BUILT SUBMITTAL	6/26/01	

PRINCIPAL PARTICULARS:

LENGTH (MOLDED) = 300'-0"  
 BEAM (MOLDED) = 100'-0"  
 DEPTH (MOLDED AT SIDE) = 13'-6"  
 DEPTH (AT § ) = 14'-0"  
 MAXIMUM DRAFT WITH GATES = 8'-0"  
 DISPLACEMENT (FRESH WATER) = 6,430 LT  
 MAIN DECK LOADING = 1,000 psf  
 ABS CLASS = MALTESE CROSS A1 FLOATING  
 CRANE FOR SERVICE ON RIVERS,  
 REINFORCEMENT A.

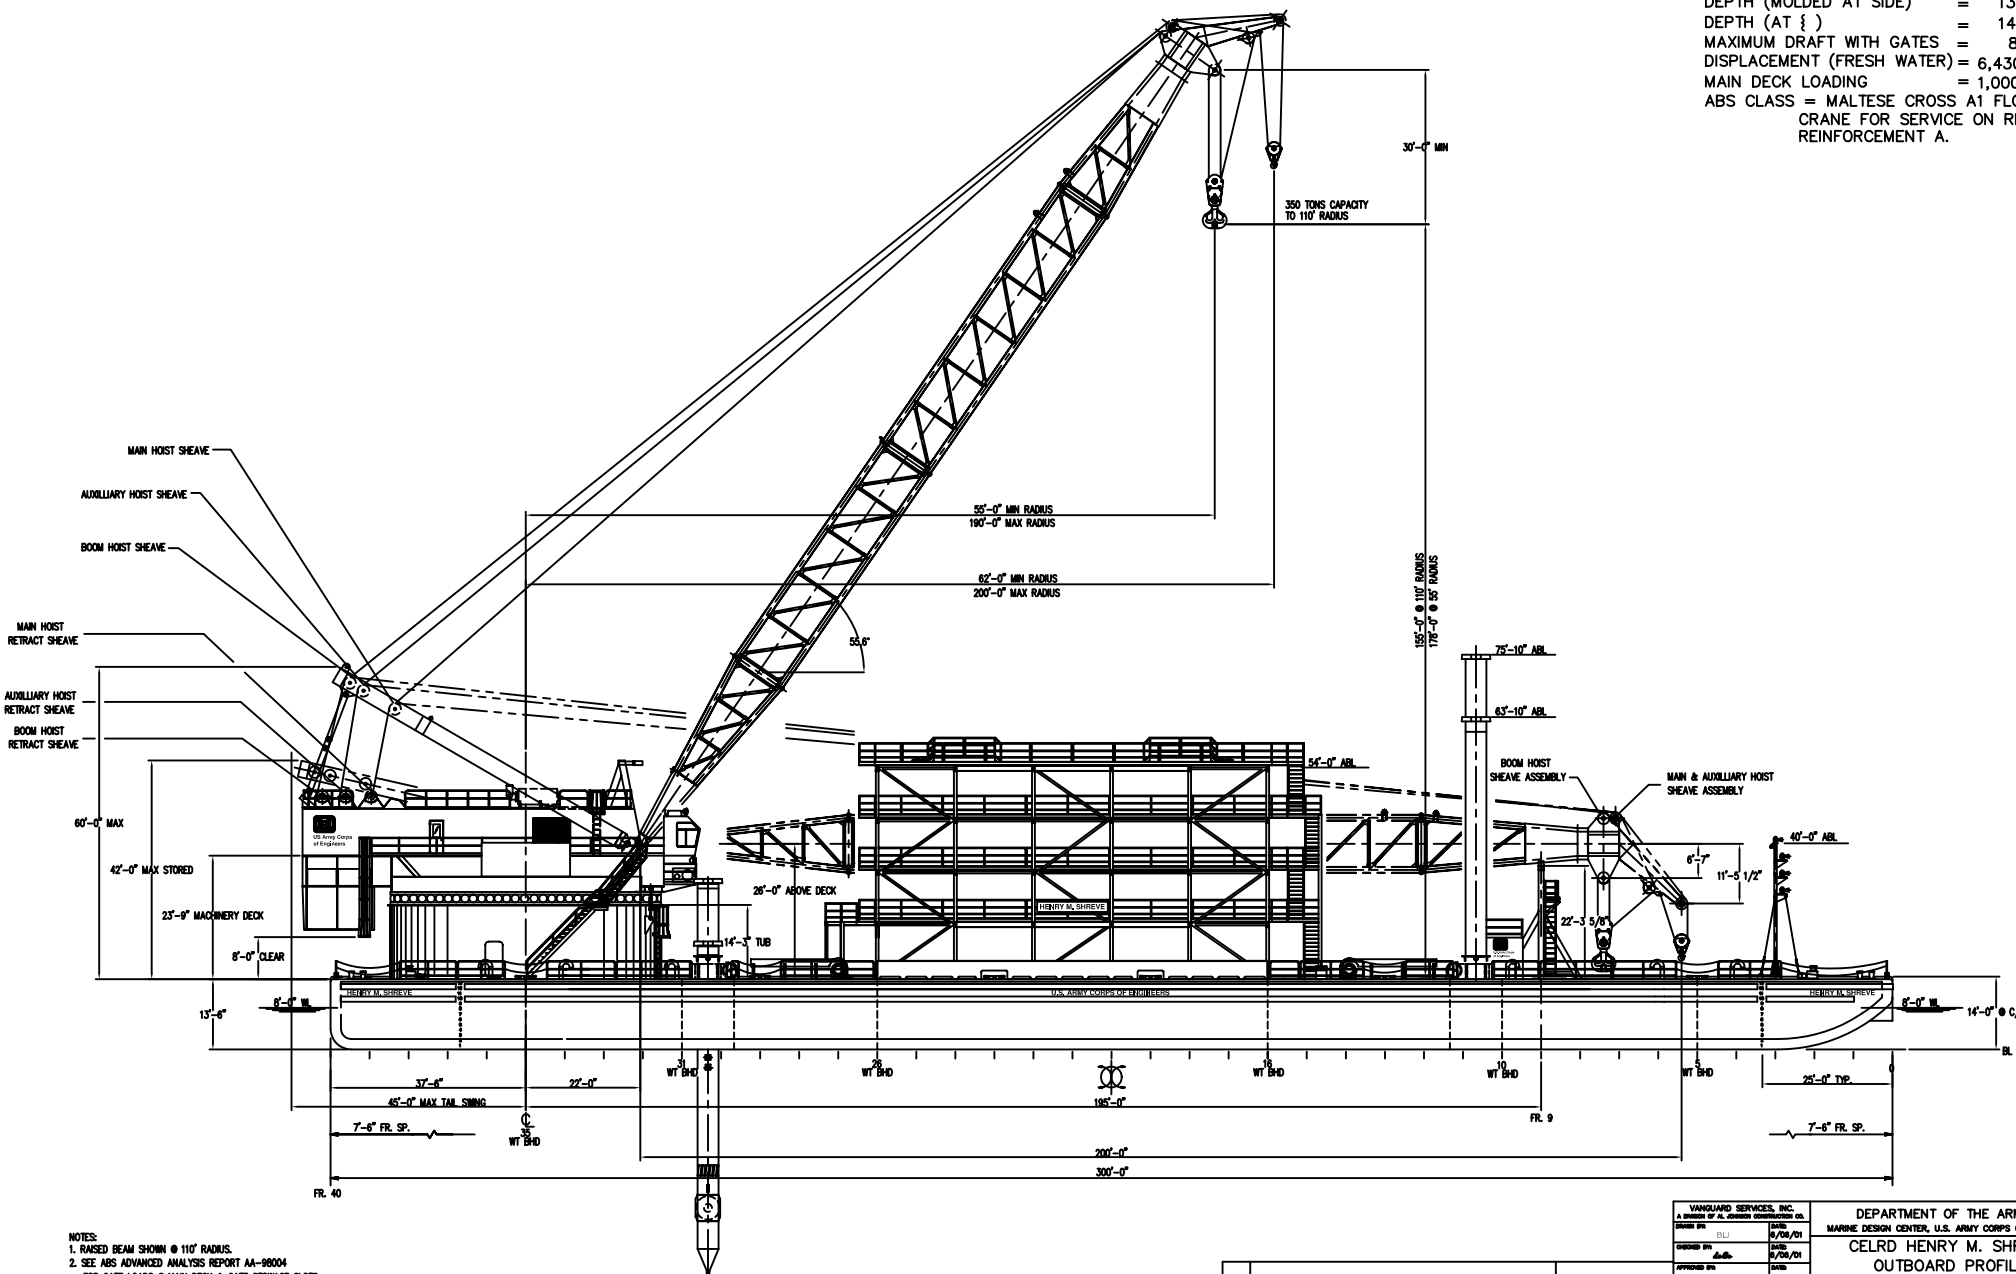


NOTES:  
 1. RAISED BEAM SHOWN @ 110' RADIUS.  
 2. SEE ABS ADVANCED ANALYSIS REPORT AA-98004  
 FOR GATE LOADS @ MAIN DECK & GATE STORAGE SLOTS.

NO.	TITLE	DRWG. NO.


VANGUARD SERVICES, INC. A DIVISION OF A. J. JOHNSON CORPORATION CO.		DEPARTMENT OF THE ARMY MARINE DESIGN CENTER, U.S. ARMY CORPS OF ENGINEERS	
DESIGNED BY: BLU CHECKED BY: JLB APPROVED BY: JLB	TITLE: 2305 DATE: 6/26/01	CELRD HENRY M. SHREVE OUTBOARD PROFILE AS BUILT	
APPR. DATE: 6/26/01 DRG. NO.: 550-D205-01	SHEET NO.: 1 OF 1	550-D205-01	

550-D205-01


REVISIONS		
NO.	DESCRIPTION	DATE
1	AS BUILT GENERAL	10/10/01

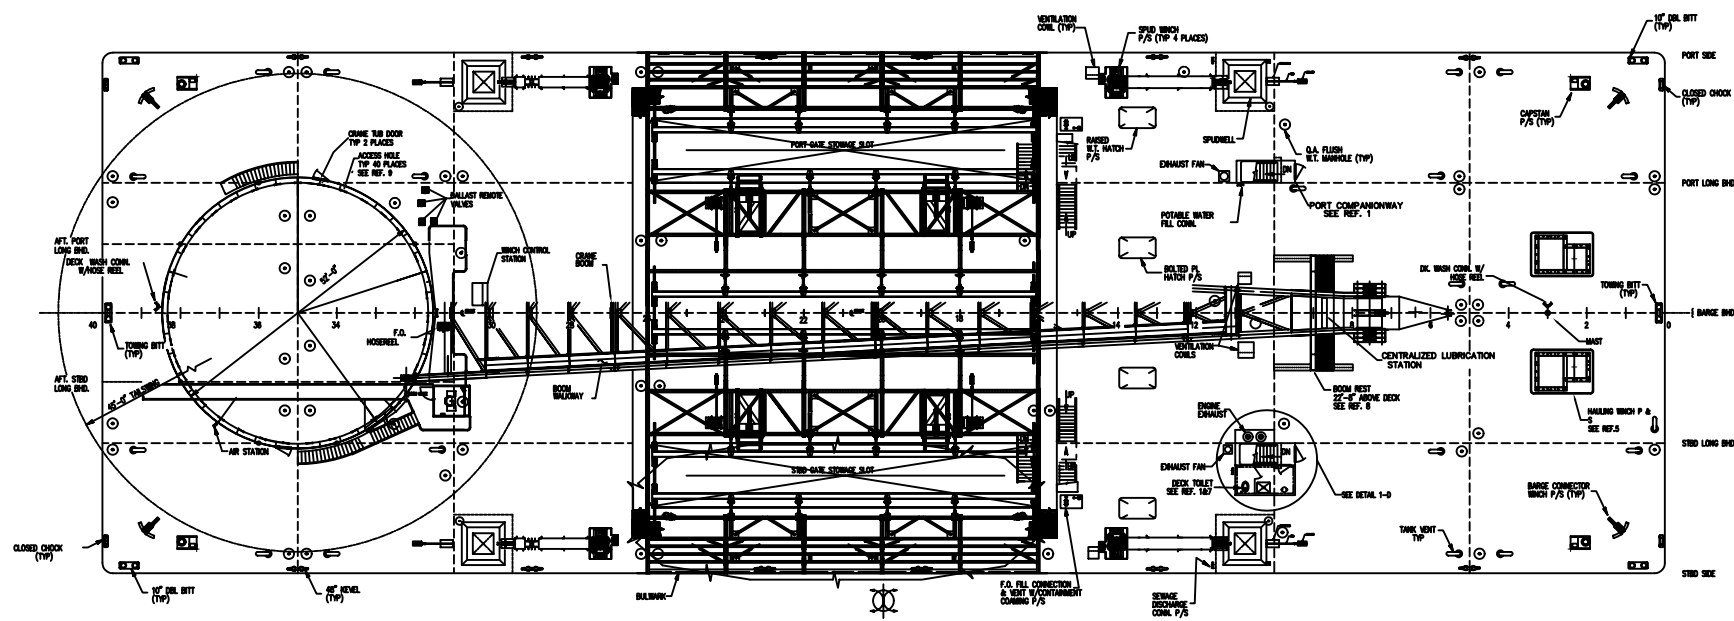

PLAN AT MAIN DECK

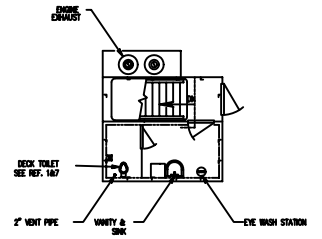

DETAIL 1-D

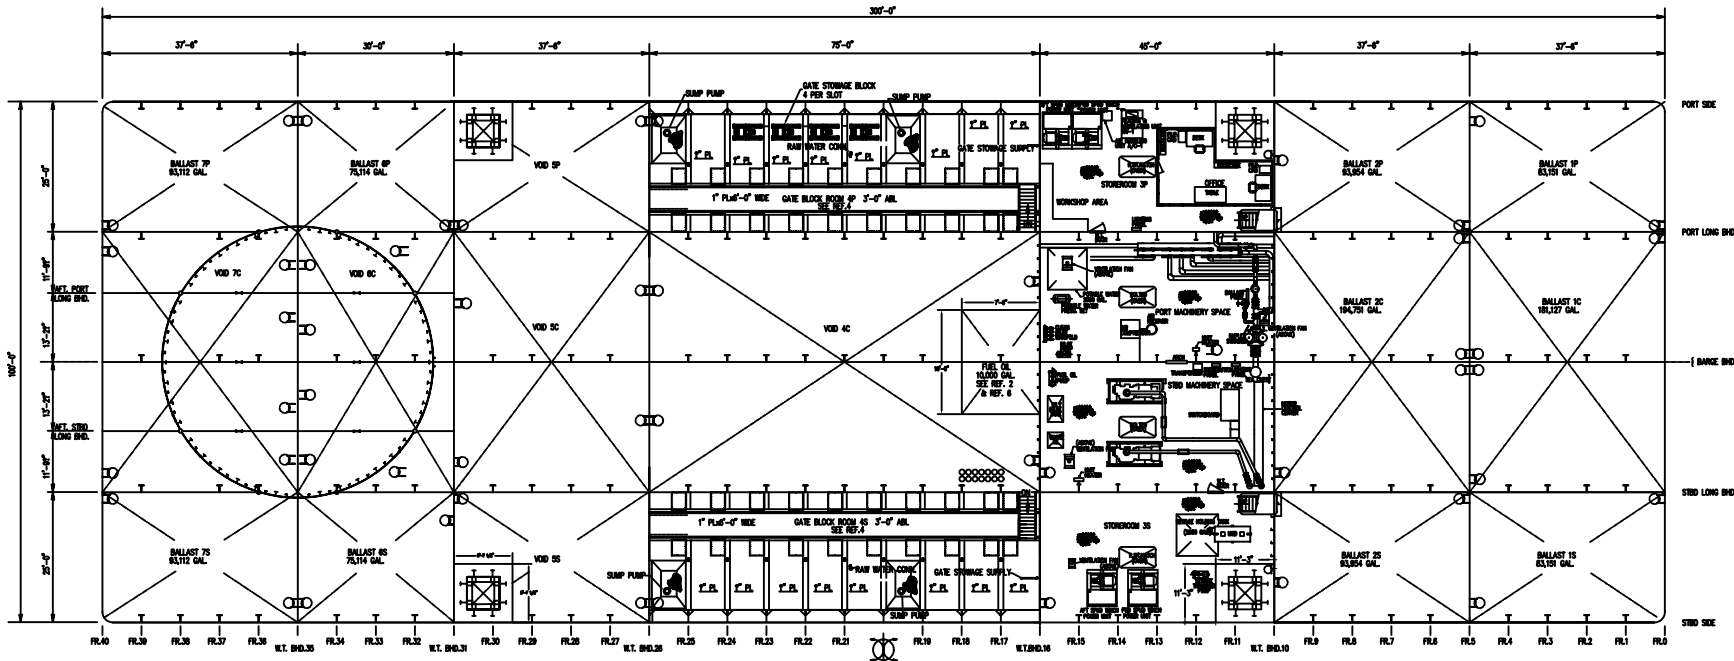

PLAN AT HOLD

**PRINCIPAL PARTICULARS:**

- LENGTH (MOLDED) = 300'-0"
- BEAM (MOLDED) = 100'-0"
- DEPTH (MOLDED AT SIDE) = 13'-6"
- DEPTH (AT { ) = 14'-0"
- MAXIMUM DRAFT WITH GATES = 8'-0"
- DISPLACEMENT (FRESH WATER) = 6,430 LT
- MAIN DECK LOADING = 1,000 psf
- ABS CLASS = MALTESE CROSS A1 FLOATING CRANE FOR SERVICE ON RIVERS, REINFORCEMENT A.

NO.	DESCRIPTION	NO.	DESCRIPTION
1	DECK COVERS	1	DECK COVERS
2	FUEL OIL SYSTEM	2	FUEL OIL SYSTEM
3	SPURWELLS	3	SPURWELLS
4	WALKS & BALLAST	4	WALKS & BALLAST
5	WALKS	5	WALKS
6	MACHINERY ARRANGEMENT	6	MACHINERY ARRANGEMENT
7	WALKS AND SERVICE STRUCTURES	7	WALKS AND SERVICE STRUCTURES

VANGUARD SERVICES, INC. A Division of A. J. Stevens Construction Co.		DEPARTMENT OF THE ARMY MARINE DESIGN CENTER, U.S. ARMY CORPS OF ENGINEERS	
DESIGN BY	BLJ	DATE	10/10/01
CHECKED BY	SMH	SCALE	AS SHOWN
PROJECT NO.		550-D215-01	
SHEET NO.		1 OF 2	

550-D215-01

A

F

E

D

C

B

A

F


E

D

C

550-D215-01 A

A


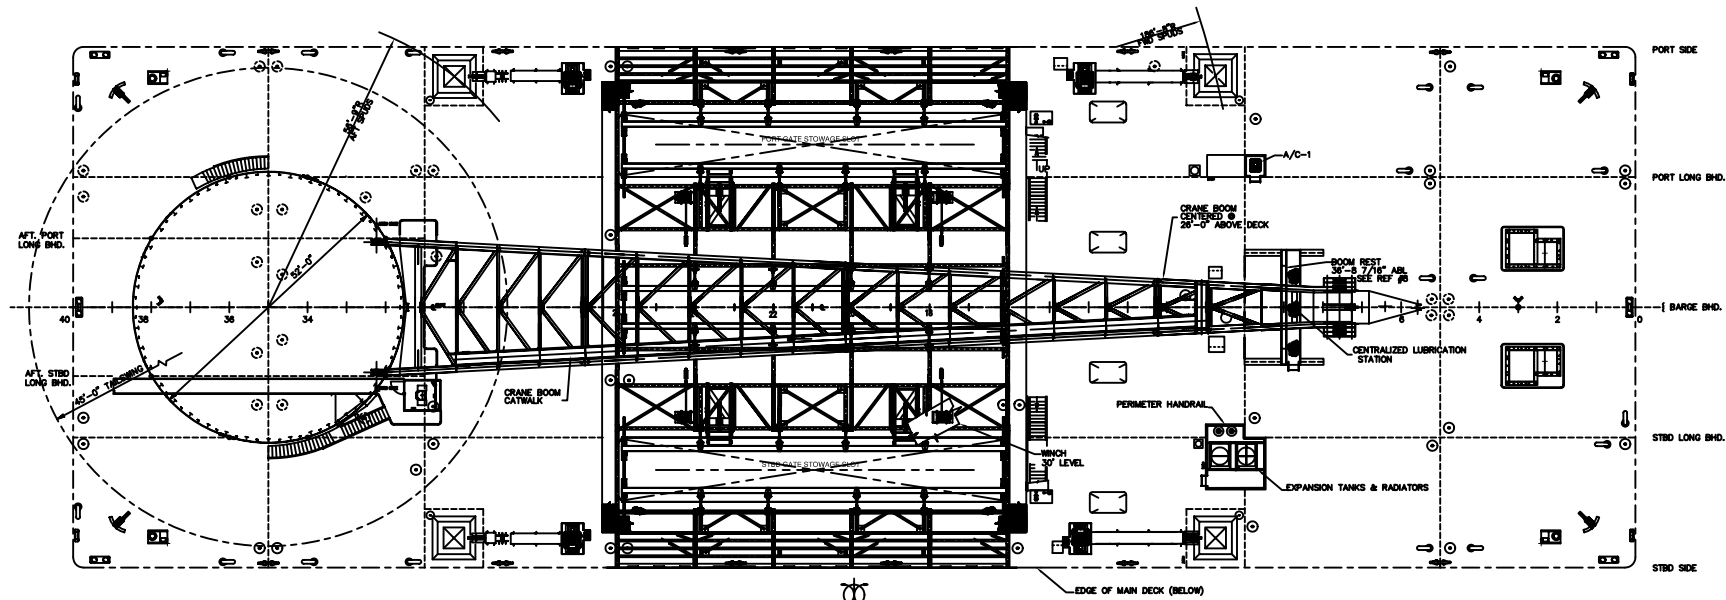


PLAN ABOVE MAIN DECK

FIG. NO.	2305	FIG. NO.	550-D215-01	FIG. NO.	A
SCALE 1" = 1'-0"		SHEET 2 OF 2			

REVISIONS		
NO.	DESCRIPTION	DATE
-	AS BUILT	10/10/50

F  
E  
D  
C  
B  
A

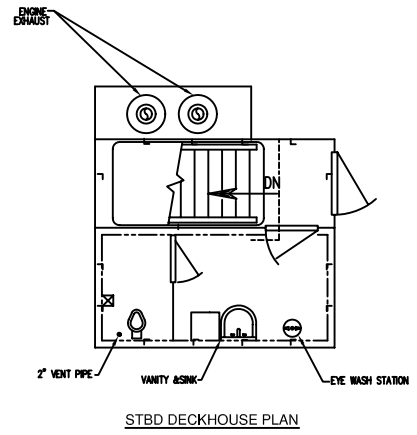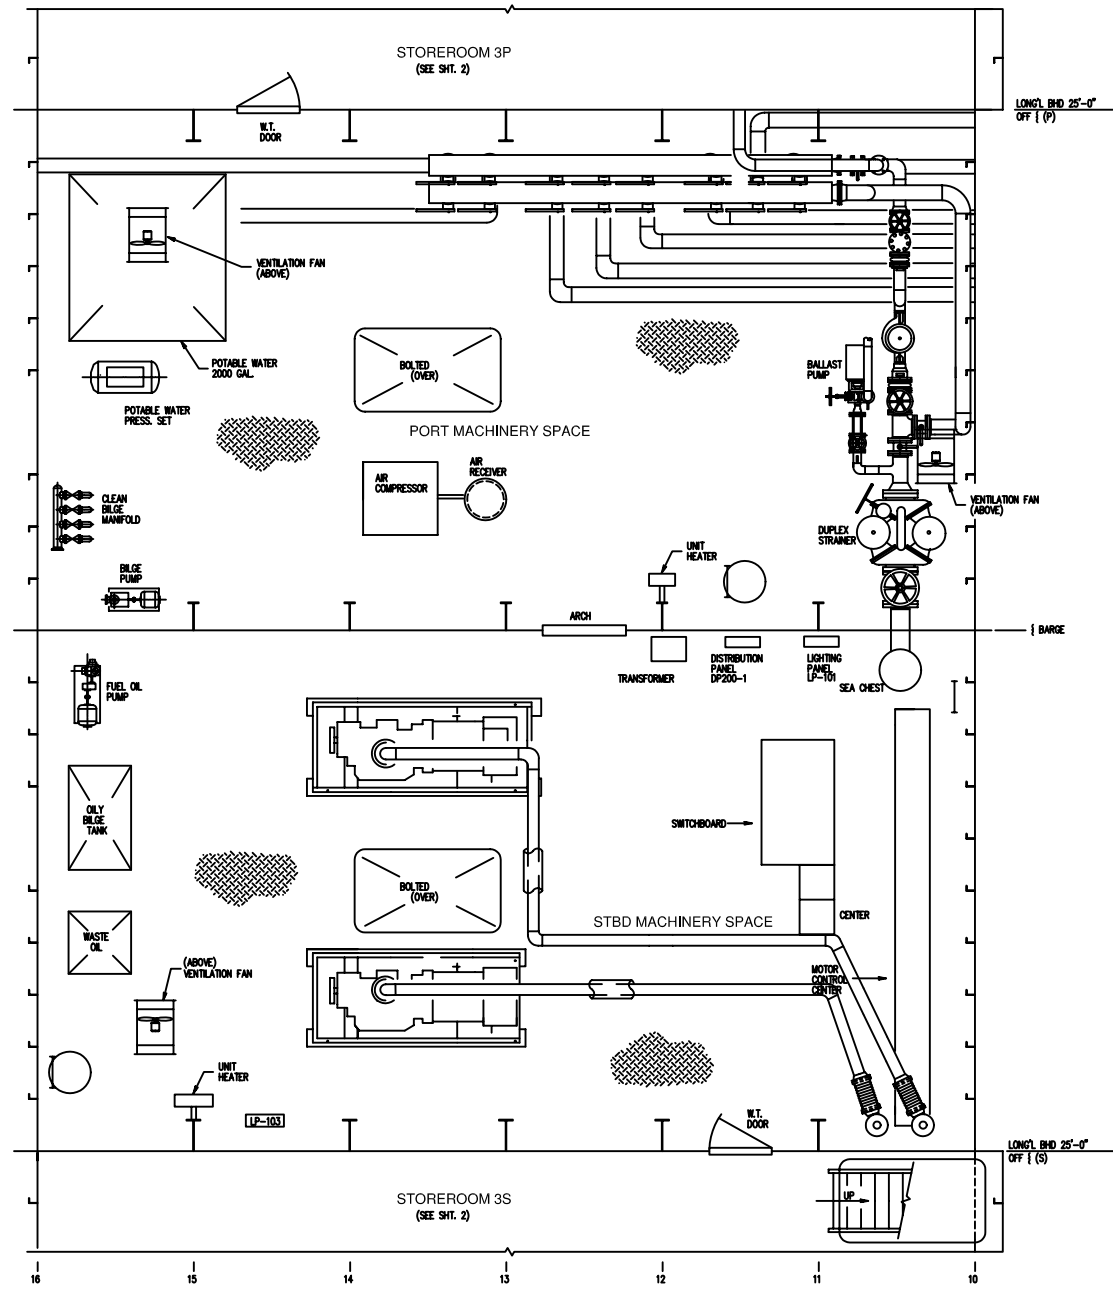


PLAN AT HOLD


NO.	DESCRIPTION	DATE
1	FIRE ALARM AND EXTINGUISHING	550-D677-01

VANGUARD SERVICES, INC. A DIVISION OF A. J. JOHNSON ENGINEERING CO.		DEPARTMENT OF THE ARMY	
DESIGN NO.	550-D245-01	NAVY DESIGN CENTER, U.S. ARMY CORPS OF ENGINEERS	
DESIGNER	CELRO HENRY M. SHREVE	MACHINERY ARRANGEMENT AS BUILTS	
DATE	10/10/50	NO.	2305
SCALE	AS SHOWN	DATE	550-D245-01
BY		APP. BY	
CHECKED BY		DATE	
REFERENCES		NO.	2

550-D245-01

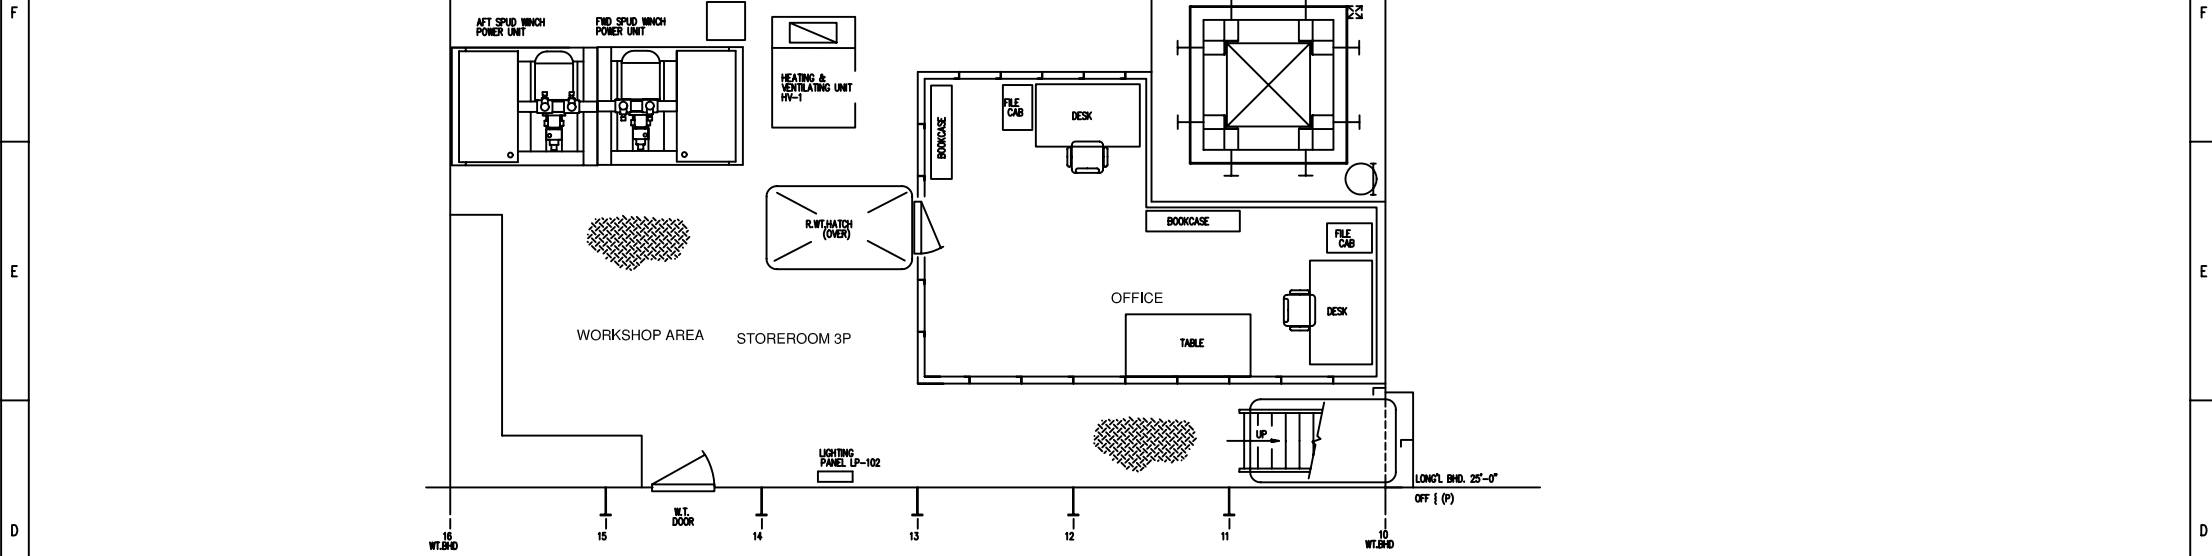

PLAN AT HOLD

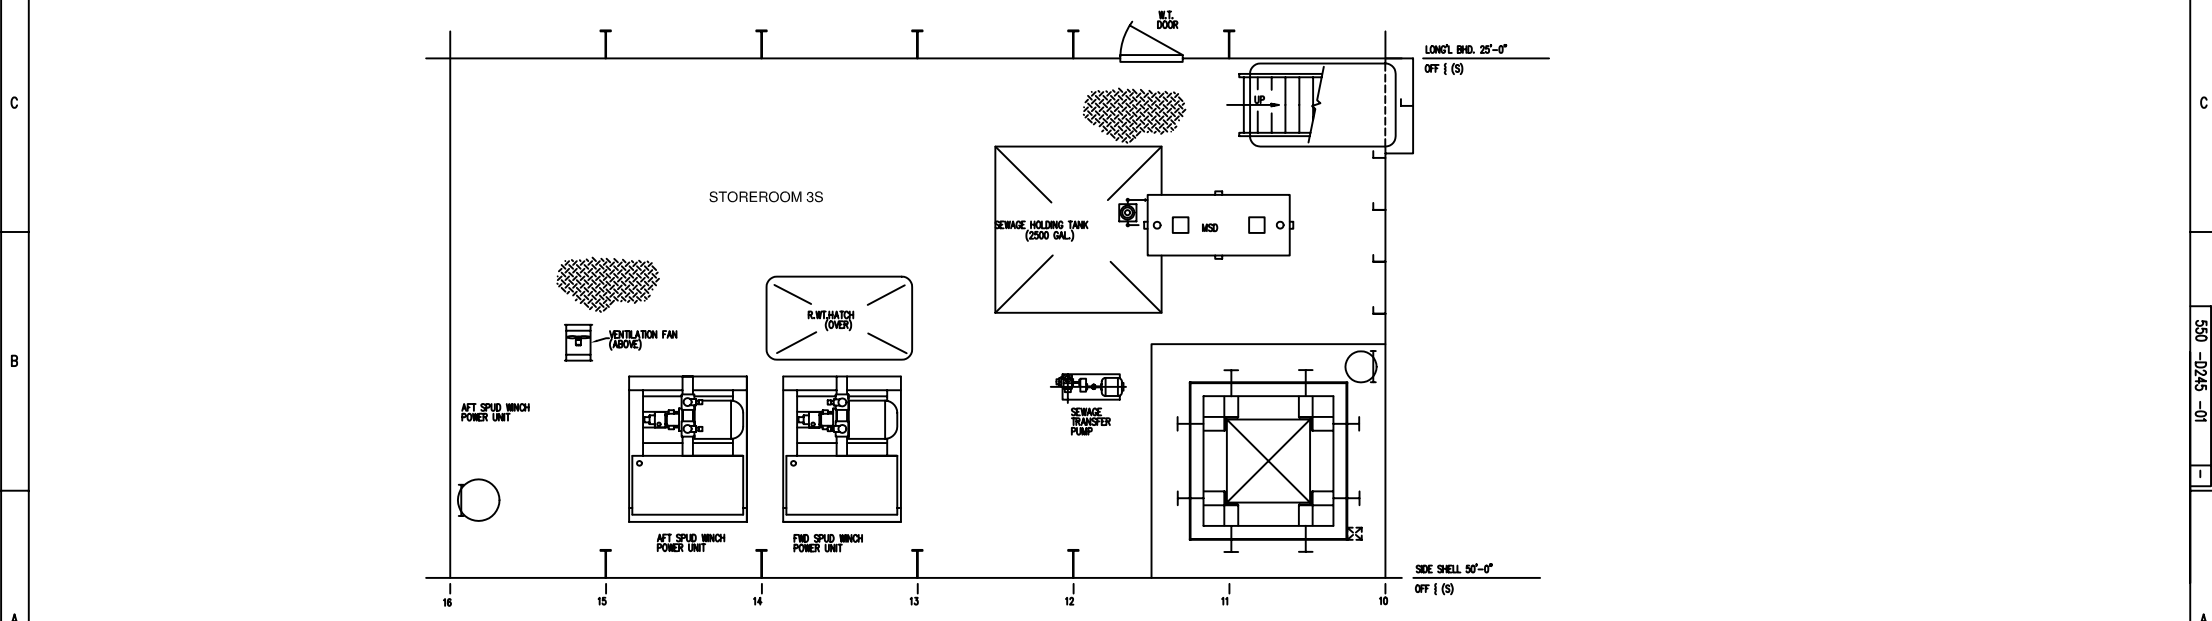

PLAN AT HOLD

550 -D245 -01 -1

REV	DATE	BY	CHK	APP	DESCRIPTION
F	2305				550 -D245 -01
					2