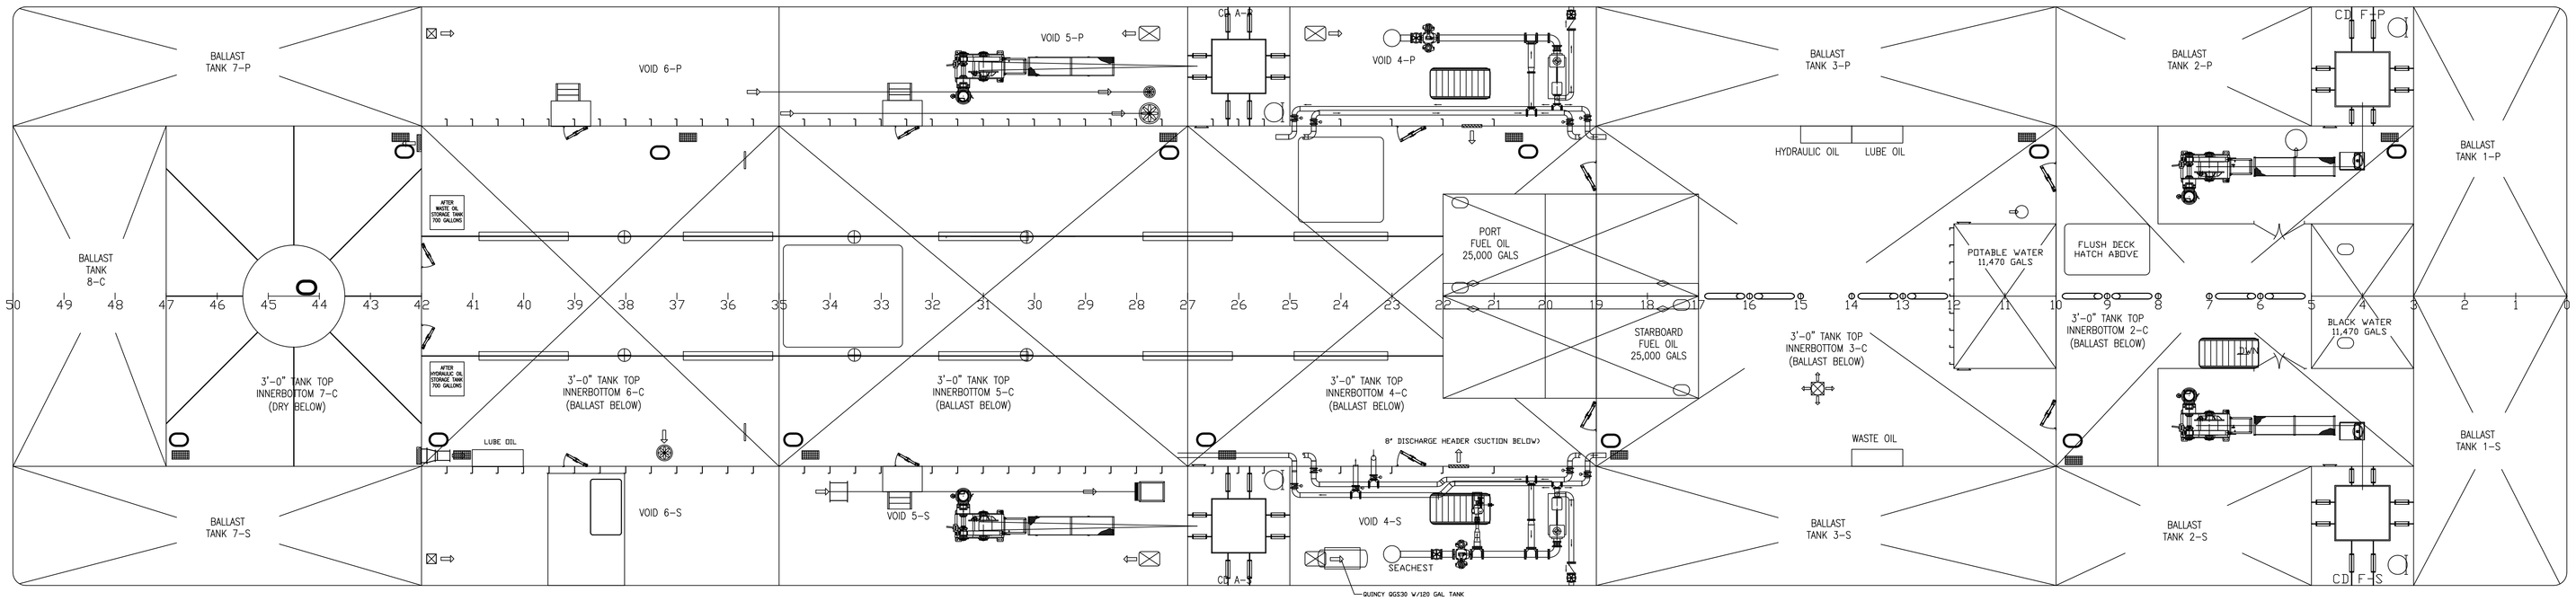

HOLD PLAN VIEW

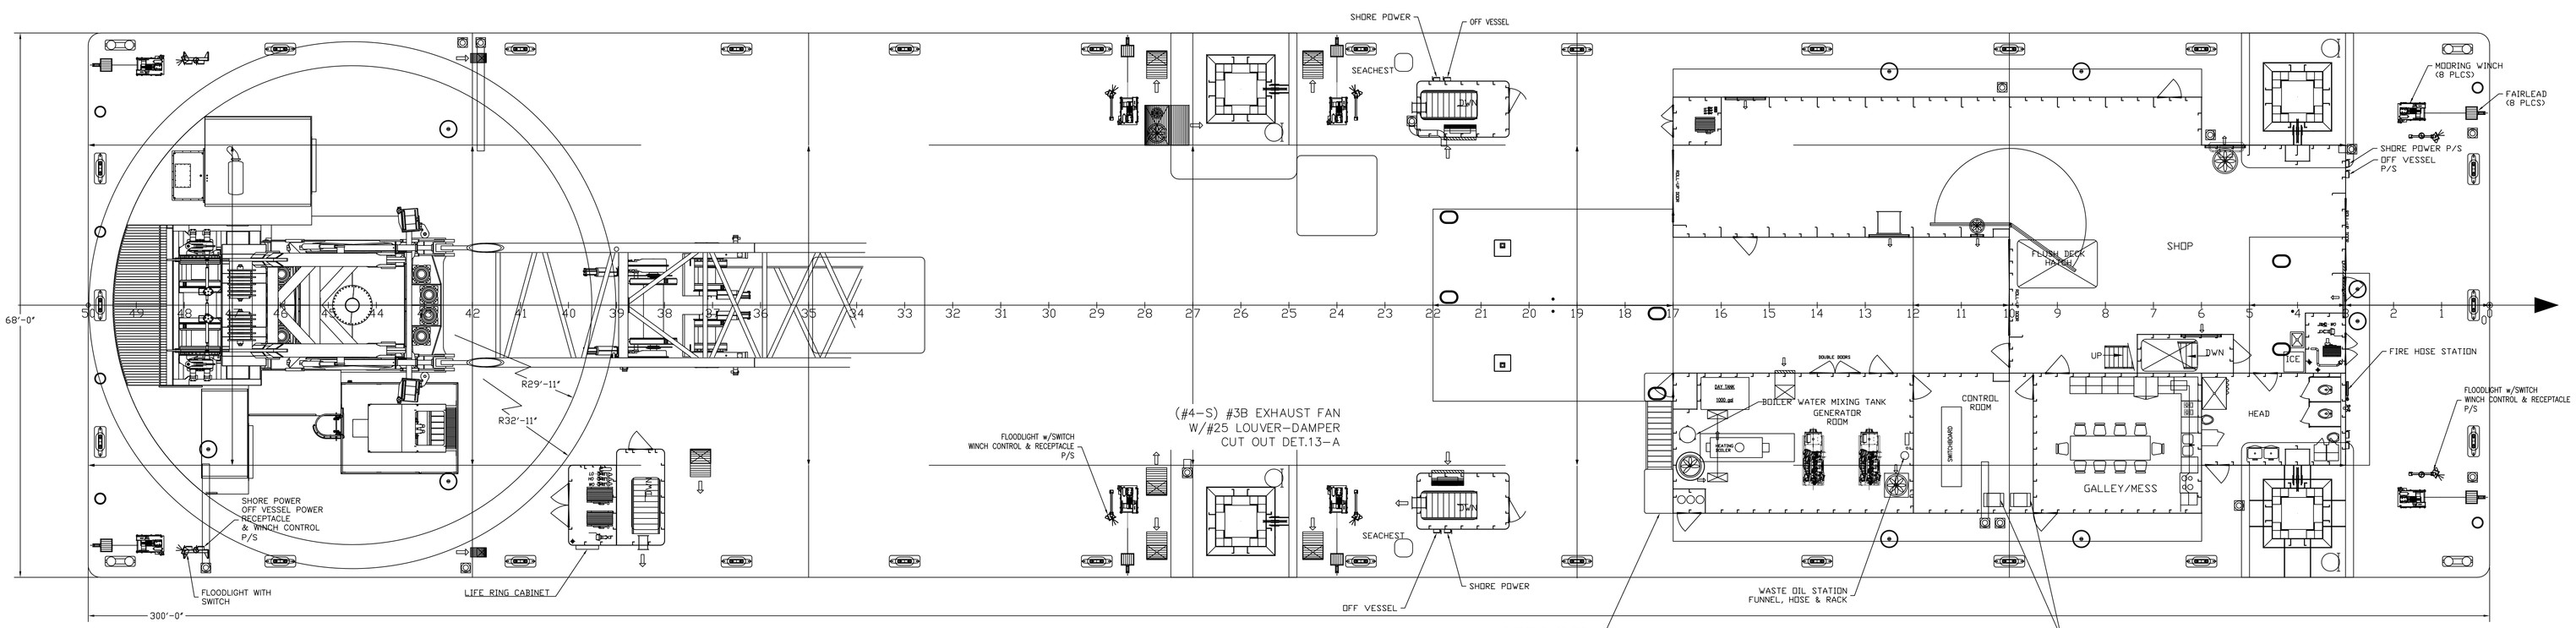

MAIN DECK PLAN VIEW

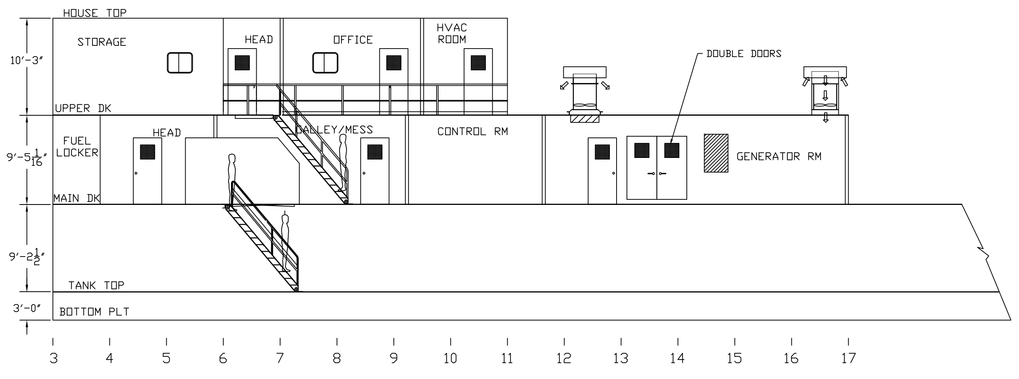

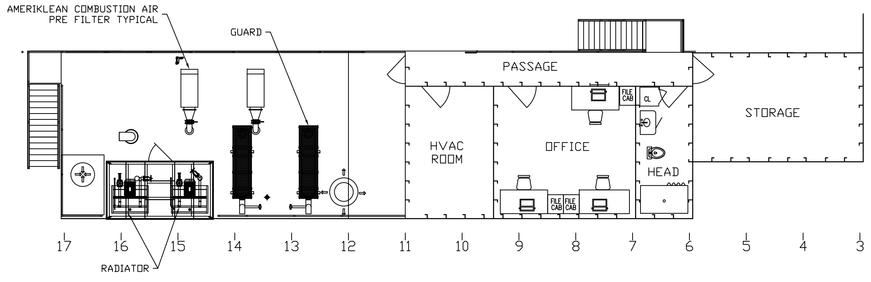

UPPER DECK PLAN VIEW (FRAME 03-17)

8'-6" TO 20'-0" STARBOARD OF CENTERLINE

CONRAD AS-BUILT
7/23/2019

REV.	ZONE	DESCRIPTION	DATE	DRAWN	CHECKED

REVISION HISTORY

CONRAD Shipyard, L.L.C.

DEPARTMENT OF THE ARMY
MARINE DESIGN CENTER
CORPS OF ENGINEERS
215 656-6850

DRAWN BY:	CHECKED BY:
BSR	BSR
DATE: 08/08/2017	CONRAD HULL #: 1167
CONRAD DWG #: C1167-801-F1	
MARINE DESIGN CENTER	
APP'D BY:	
DATE:	

US Army Corps of Engineers

CEMVR, FLOATING CRANE
300'x 68'x 12'

GENERAL ARRANGEMENT

SIZE	PROJECT NO.	DWG NO.	REV
E	2685	703-D215-01	0

SCALE 1/8" = 1'-0" SHEET 1 OF 1